


Cowley

KANSAS

SECTION 6 TOWNSHIP 35 RANGE 3 E

WELL NO. #2 Albright

COMPANY Hill & Hill

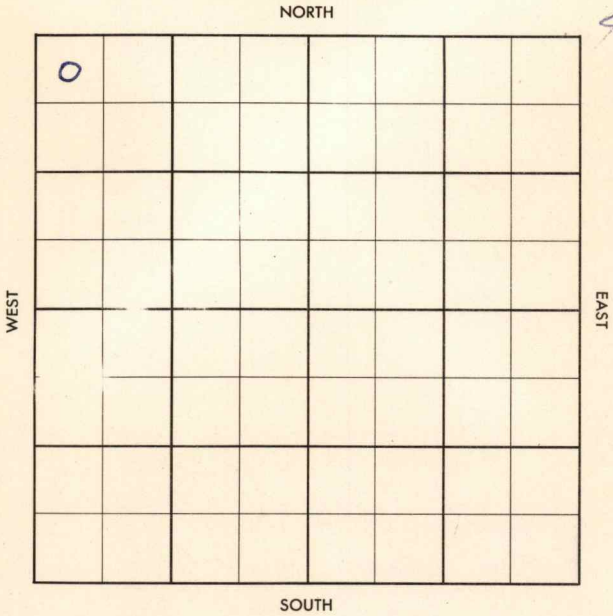

Cowley

KANSAS

SEC.

TWP.

R.

6

35

3E

WELL NO.

#2 Allbright

FARM

COMPANY

Hill & Hill

CONTRACTOR

Kriswell


Murphy

Ft. from N. Line

Ft. from S. Line

Ft. from E. Line

Ft. from W. Line

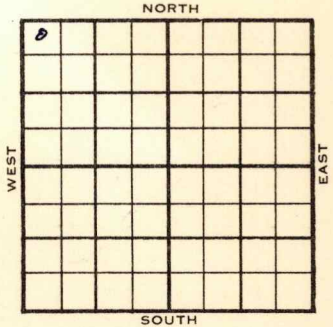

NW NW NW

	ELEVATION	REPORT
1955	1210'	

11/9	R U R
------	-------

11-29	Comm. 11-8-55 8 5/8" @ 137 D & A Bartl. 3500' TD 3565'
-------	--

ABANDONED

County **Cowley** Elev. _____
Sec. **6** Twp. **35** Rge. **3E**
Company **Hill & Hill**
Farm Name **Allbright** No. **2**

TOPS	DEPTH	LOG	DATUM	Loc. in Sec.
Anh.				NW NW NW
T.P.				
H.				
Tr.				
Dg.				
Bl.				
L.				
K.C.				Geol.
B.K.C.				Contr.
Ce.				Kriswell
C.				
M.				
M.				Pool
K.				Murphy
Mz.				
Mq.				
V.				
S.				
S.				
A.				
R.				
Pe.				
G.				
T.D.				

0

NOV 9 1955

FIRST REPORT

Date Comm. **RUR**

T. _____

R. _____
