


Section 6 Township 35 Range 3 EWell No. # 2 BartonCompany Bowman & Grissmore

NORTH

WEST

EAST

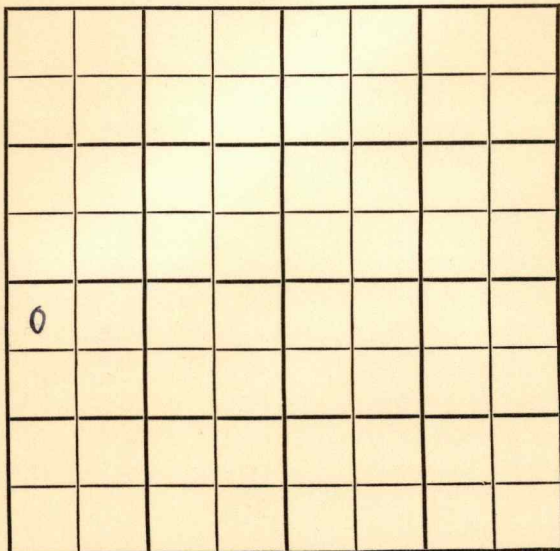

SOUTH

FABEN GILSTRAP

O.W.W.O.

FORM 513 REV. SUNRAY

OWWO

County Cowley Elev. 1207
 Sec. 6 Twp. 35 Rge. 3E
 Company Bowman & Grissmore
 Farm Name Barton No. 2

Co.

Lse.

No.

Sec.

T.

R.

TOPS	DEPTH	LOG	DATUM	Loc. in Sec.
Anh.				NW NW SW
Tr.				
H.				
Tr.				
Dg.				
Bl.				
L. <u>Layton</u>	<u>2780</u>			Geol.
K.C.	<u>2972</u>			Contr.
B.K.C. <u>Cleve.</u>	<u>3101</u>			<u>Springer &</u>
Ce. <u>Oswego</u>	<u>3192</u>			<u>Harper</u>
C. <u>Bart.</u>	<u>3164</u>			Pool
M. <u>Bart. sd</u>	<u>3170</u>			<u>Murphy</u>
M. <u>We. Miss</u>	<u>3555</u>			
K. <u>Miss</u>	<u>3594</u>			
Mz.				
Me.				
V.				
S.				
S.				
A.				
R.				
P.E.				
G.				
T.D.	<u>3 625</u>			

FIRST REPORT

NOV 16 1955

Date Comm.

00 set 5" @ 3571

OWWO

County Cowley Elev. 1207
Sec. 6 Twp. 35 Rge. 3E
Company Bowman & Grissmore
FarmName Barton No. 2

TOPS	DEPTH	LOG	DATUM	Loc. in Sec.
Anh.				NW NW SW
Tp.				
H.				
Tr.				
Dg.				
BL.				
L. <u>Layton</u>	<u>2780</u>		<u>1573</u>	Geol.
K.C. <u></u>	<u>2972</u>		<u>1765</u>	
B.K.C. <u>Clene</u>	<u>3101</u>		<u>1894</u>	Contr.
Ce. <u>Bowman</u>	<u>3192</u>		<u>1985</u>	Springer &
C. <u>Bart</u>	<u>3464</u>		<u>2257</u>	Harper
M. <u>Bart</u>	<u>3479</u>		<u>2271</u>	Pool
M. <u>Wen. Miss</u>	<u>3555</u>		<u>2348</u>	Murphy
K. <u>Miss</u>	<u>3594</u>		<u>2387</u>	
Mz.				
Me.				
V.				
S.				
S.				
A.				
R.				
Pe.				
G.				
T.D.	<u>3625</u>			

COMPLETE

Date Comm. JAN 1 1 1956

CO 5" @ 3571 CO to 3500
56/ 3482-94 FU 700' oil 1300' sw 12 hr
Comp. 40 bopd 50% wtr.