

Cowley

KANSAS

SECTION 6 TOWNSHIP 35 RANGE 3 E

WELL NO. #4 Barton

COMPANY Bowman-Grissmore

NORTH

	0						

12

WEST

EAST

SOUTH

Cowley

KANSAS

SEC. 6	TWP. 35	R. 3E
-----------	------------	----------

WELL NO.

#4 Barton

FARM

COMPANY

Bowman- Grissmore

CONTRACTOR

~~Capit~~ Capitt

Hilltop


Ft. from N. Line

Ft. from S. Line

Ft. from E. Line

Ft. from W. Line

SE NW SW

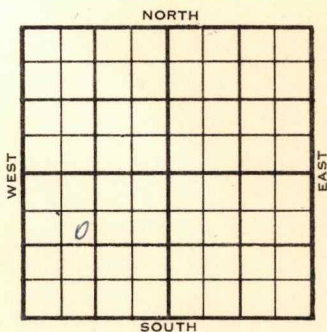

	ELEVATION	REPORT
1956	1204	
1-5	Comm. 12-29-55 8" @ 135 Drlg. 3008	
2-8	S/ & Flw 25 BOPD / est 5% wtr. Lay 2780 KC 2968 Clev 3098 OSW 3183 Cattle 3394 Bartl. 3460 Bartl. sd. 3488 Miss. 3534 TD 3574	

COMPLETED

County Coxley Elev. _____
Sec. 6 Twp. 35 Rge. 3E
Company Bowman-Grissmore
Farm Name Barton No. 4

TOPS	DEPTH	LOG	DATUM
Anh.			
T.P.			
H.			
Tr.			
Dg.			
BL.			
L.			
K.C.			
B.K.C.			
Ce.			
C.			
M.			
M.			
K.			
Mz.			
Mo.			
V.			
S.			
S.			
A.			
R.			
Pe.			
G.			
T.D.			

Loc. in Sec. SE NW SW

Geol. _____

Contr. Capitt

Pool Hilltop

FIRST REPORT	
JAN 5 '56	

Date Comm. 12-29-55

8" @ 135 drlg. 3008

County Cowley Elev. 1204
 Sec. 6 Twp. 35 Rgs. 3E
 Company Bowman-Grissmore
 Farm Name Barton No. 4

TOPS	DEPTH	LOG	DATUM	Loc. in Sec.
Anh.				
Tp. <u>624</u>	<u>2780</u>		<u>1576</u>	<u>SE NW SW</u>
H.				
Tr.				
Dg.				
Bl.				
L.				
K.C.	<u>2968</u>		<u>1764</u>	Geol. _____
B.K.C. <u>cler</u>	<u>3098</u>		<u>1894</u>	Cont. _____
Ce. <u>OSW</u>	<u>3183</u>		<u>1979</u>	<u>Capitt</u>
C. <u>cahle</u>	<u>3294</u>		<u>2190</u>	
M. <u>Bartle</u>	<u>3460</u>		<u>2256</u>	
M. <u>" sd</u>	<u>3488</u>		<u>2284</u>	Pool _____
K. <u>Miss</u>	<u>3534</u>		<u>2330</u>	<u>Hilltop</u>
Mz.				
Ms.				
V.				
S.				
S.				
A.				
R.				
Pe.				
G.				
TD	<u>3574</u>			

COMPLETE

Date Comm. 12-29-55 FEB 8 1956

8" @ 135 drlg. 3008 JAN 11 '56 5 1/2 3574

JAN 18 '56 5 1/2 3573 CO 8/3508-10

FD 280' Fluid in 8 hrs (mostly

Wtr) JAN 25 '56 56d 3508-10 WOC

FEB 1 '56 ✓ FEB 8 '56 CO 3510 60/3490

-3505 & 8' Flw 25 Bapd +

est 5% Wtr.