

# KANSAS


Barton

FORM 51 5M 1-42 PETROL

Section 31 Township 16 Range 11-W

Well No. #1 Zorn

Company Gulf

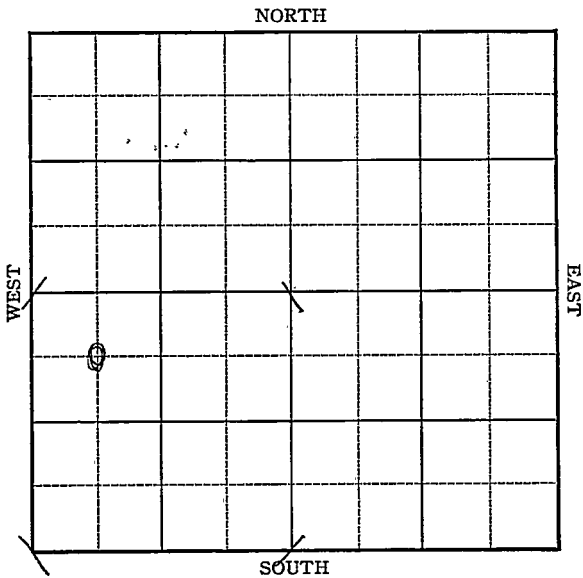

Sec. 31 Twp. 16 R. 11 W

Well No. #1 Zorn Farm

Gulf Company

Kraft Prusa


660 Ft. from N. Line

\_\_\_\_\_ Ft. from S. Line

\_\_\_\_\_ Ft. from E. Line

660 Ft. from W. Line

*Elev. 1894*

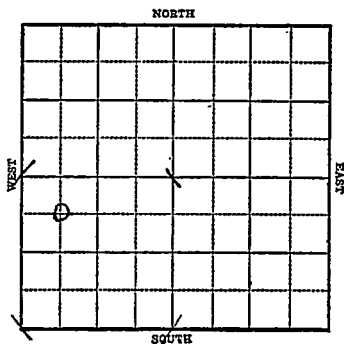

1943

R E P O R T

3/17 Location.  
 3/24 10" @ 329' WOC.  
 3/31 Topeka 2700 Drlg.  
 4/14 Arb. 3360  
 T.D. 3400'  
 Water

**ABANDONED**

Barton

KANSAS

Map No. 55 Sec. 31 Twp. 16 R. 11W

Well No. 1 Zorn

Gulf Company

**FIRST REPORT**

Contractor

C NW SW

**SECTION PLAT**

660 Ft. from N. Line

\_\_\_\_\_ Ft. from S. Line

\_\_\_\_\_ Ft. from E. Line

660 Ft. from W. Line

|  |  |  |  |
|--|--|--|--|
|  |  |  |  |
|  |  |  |  |
|  |  |  |  |
|  |  |  |  |

**KRAFT PRUSA POOL**

Location ~~KXX~~

Rig up \_\_\_\_\_

Drilling and Remarks:

**RECORD**

Cased \_\_\_\_\_ in., \_\_\_\_\_ ft.

Sand \_\_\_\_\_

Gas \_\_\_\_\_

Oil \_\_\_\_\_

Total Depth: \_\_\_\_\_

**PRODUCTION**

1st 24 hrs. Nat. \_\_\_\_\_

1st 24 hrs. after shot \_\_\_\_\_

Gas \_\_\_\_\_ Cu. Ft.

Dry Hole \_\_\_\_\_

Abandoned \_\_\_\_\_

Date

MAR 17 1943

19

S. J. LEWIS Scout

KANSAS

Barton

Map No. 58 Sec. 31 Twp. 16 R. 11WWell No. 1 Zorn

Gulf

Company

ABANDONED

Contractor

C NW SW

## SECTION PLAT

660 Ft. from N. Line

\_\_\_\_\_ Ft. from S. Line

\_\_\_\_\_ Ft. from E. Line

660 Ft. from W. Line

|   |  |  |  |
|---|--|--|--|
|   |  |  |  |
|   |  |  |  |
| o |  |  |  |
|   |  |  |  |

KRAFT PRUSA POOL

Location \_\_\_\_\_

Rig up \_\_\_\_\_

Drilling and Remarks:

*Cr 83360**Water.*

## RECORD

Cased \_\_\_\_\_ in., \_\_\_\_\_ ft.

Sand \_\_\_\_\_

Gas \_\_\_\_\_

Oil \_\_\_\_\_

Total Depth 3400

## PRODUCTION

1st 24 hrs. Nat. \_\_\_\_\_

1st 24 hrs. after shot \_\_\_\_\_

Gas \_\_\_\_\_ Cu. Ft.

Dry Hole \_\_\_\_\_

Abandoned \_\_\_\_\_

Date

APR 14 1943 19S. J. LEWIS Scout