

O.W.W.O.

KANSAS

Barton

KANSAS


Section 31 Township 16 Range 11WWell No. #4 ZornCompany Skelly

Kraft-Prusa Pool

NORTH

WEST

EAST

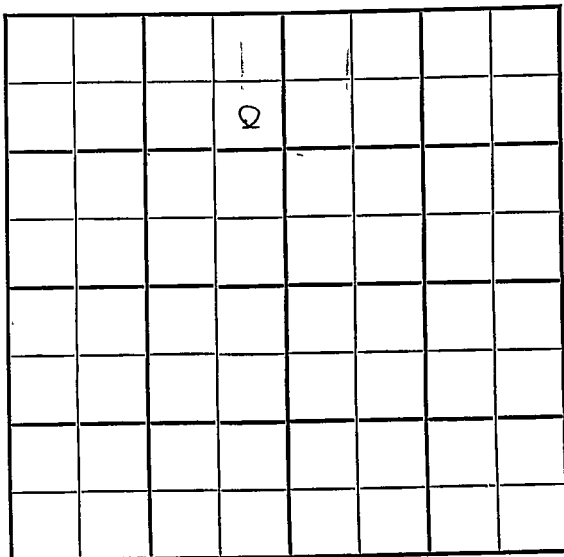

SOUTH

KANSAS

Barton

O.W.W.O.


Sec. 31 Twp. 16 R. 11WWell No. #4 Zorn Farm

Skelly Company

Kraft-Prusa

990 Ft. from N. Line Ft. from S. Line330 Ft. from E. Line Ft. from W. Line

SE NE NW

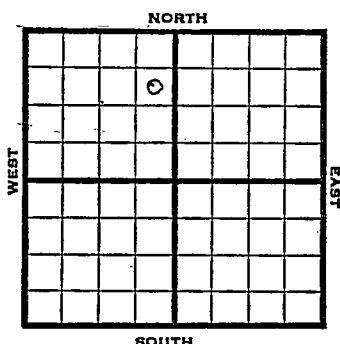

1948

Eli 1928'

REPORT

4/14

Location

4/21

Surface Hole

4/28

8" @ 380'

Dr1g. 2015'

5/5

Lansing 3014'

Pre Camb 3180-84'

TD 3184'

5" @ 3180'

RUST

5/12

"

5/19

TD 3201 $\frac{1}{2}$ - 850' oil 4 hrs.

5/26

Swb 149 bbls oil- 147 W in 20 hrs.
Squeeze

6/1

"

6/9

Packer 2885'

61 shots 2860-76 1000 acid

swb 17 bbls oil / 5 W in 15 hrs.

6/16

Squeeze

6/23

"

6/29

"

7/8

"

7/14

"

OVER

1948

7/21 - Squeeze

7/28 PB 3005'

8/4 "

8/11 "

8/18 Pipe collapsed
PB 2150'
Lansing 3011'
PreCamb. 3177-97'
TD 3197'
5" @ 3180'

8/25 "

9/1 "

9/8 "

9/15 Precamb. 3177'
TD 3233'
5" @ 3180'
P_{mp} 65 oil Pot
42⁵⁰ Gr.
Comp

COMPLETED

O.W.W.Q.

1954

3/3 Doug. 2950', PreCamb. 3177'
OTD 3233'
5" @ 3180'
DD 3316'
217' of 4" liner
34/3302-08, 23/3270-74, 56/3250-60,
450A
Sd-oil-frac, dry
30/3185-90, 52/3194-3203
Sd-oil-frac
P/13 bo 7 bwpd
PB 3064
73/2950-62
Sd-oil-frac, 9,010,000 gas, 525#

3/17 Gas Well.
TD 3316'
Doug 2950', PreCamb 3177', OTD 3233'
5" @ 3180'
DD 3316' 217' of 4" liner 34/ 3302-
08 23/ 3270-74 56/ 3250-60 450 A
sd-oi-frac dry 30/ 3185-90 52/ 3194-
3203' sd-oil-frac P/ 13 bo 7 bwpd
PB 3064 73/ 2950-62 sd-oil-frac
Comp 9,010,000 gas 525#

COMPLETED

Map No. _____ Sec. 31 Twp. 16 R. 11W

Well No. 4 Zorn

Skelly Company

FIRST REPORT Contractor

SE NE NW


SECTION PLAT

990 Ft. from N. Line

_____ Ft. from S. Line

330 Ft. from E. Line

_____ Ft. from W. Line

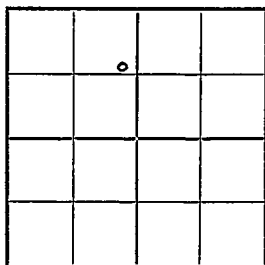

Barton County

Location X

Rig up _____

Drilling and Remarks:

RECORD

Cased _____ in., _____ ft.

Sand _____

Gas _____

Oil _____

Total Depth _____

PRODUCTION

1st 24 hrs. Nat. _____

1st 24 hrs. after shot _____

Gas _____ Cu. Ft.

Dry Hole _____

Abandoned _____

Date

APR 14 1948 19 S. J. LEWIS Scout

Barton County Kansas State

Map No. 55 Sec. 31 Twp. 16 R. 11W

Well No. 4 Zorn

Skelly Company

COMPLETE

Contractor

SE NE NW

E1, 1928
SECTION PLAT

990 Ft. from N. Line

 Ft. from S. Line

330 Ft. from E. Line

 Ft. from W. Line

Kraft-Brusa Pool

Remarks:

Pre Com 8177

ND 233

5-10-8170

Only 60 oil Prod.

42² 82

Date

Scout

S. J. LEWIS

SEP 15 1948

J. G. McGEHEE

Sec. 31 (Blk. Twp.) 16 (Sur. Rge.) 11W Map No.

Well No. 4 Farm Zorn

Elev.	1928	Location	SE NE NW
-------	------	----------	----------

o

COMPLETE

330 Ft. From E Line Quarter

1st. Report

Completion MAR 17 1954

Remarks OWWO

Spudding Date _____

Drig. Data Gas well TD 3316

Doug. 2950 PreCamb. 3177 OTD 3233

5" @ 3180 DD 3316 217' of 4" liner

34/ 3302-08 23/ 3270-74 56/ 3250-60

450 A sd-oi-frac drv 30/ 3185-90

52/ 3194-3203 sd-oil-frac P/ 13 bo

7 bwpd PB 3064 73/ 2950-62 sdCoil-frac

Comp. 9,010,000 gas 525#