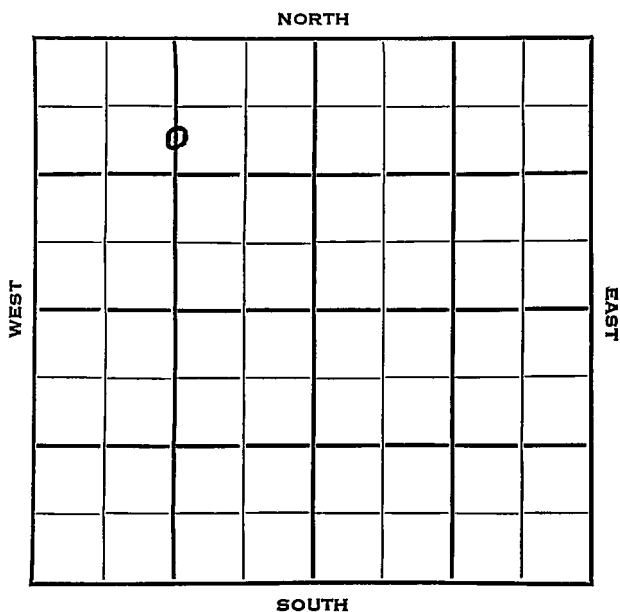


Section 31 Township 16 Range 11 WWell No. # 6 J. F. ZornCompany Skelly Oil

Barton

KANSAS

SEC.	TWP.	R.
31.	16	11 W ✓
WELL NO.		
# 6 J. F. Zorn		FARM
COMPANY		
Skelly Oil		
CONTRACTOR		

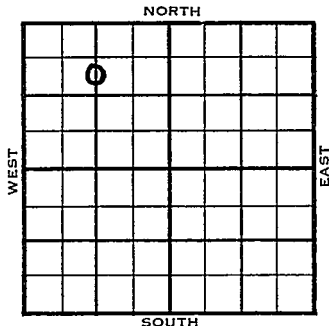
Kraft-Prusa Pool

990 Ft. from N. Line

Ft. from S. Line

Ft. from E. Line

1320 Ft. from W. Line

C S $\frac{1}{2}$ N $\frac{1}{2}$ NW

	ELEVATION	REPORT
1953	1903'	
9/30	Spud 9-23-53	
	Anhy 730'	8" @ 747 WOC
10/7	Heeb 2908'	Tor. 2924' Doug 2955'
	Br li 3005'	Lan 3017'
	Drlg. 3257'	
10/14	RTD 3315'	5" @ 3256
10/21	NR	
10/28	NR	
11/4	"	
11/11	Spud 9-23-53	
	Oil Well	
	TD 3315'	
	Anhy 730'	
	8" @ 747'	
	Heeb 2908'	Tor 2924', Doug 2955', Br.
	Lime 3005'	Lans 3017', Qt. 3242'
	TD 3315'	
	5" @ 3256'	
	CO to 3315'	
	BSO & 5 gwph PB 3286	sd-frac S/ 28
	bo 4 hr. SP 3253	46/ 3243-52 oil-
	frac (sd) S/ 8 bo 2 hr.	CO to 3283
	P/ 23 bo 4 hr.	
	Comp 108 bopd.	

COMPLETED

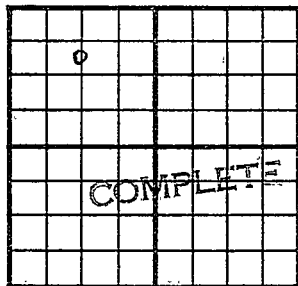
County Barton State KansasSec. 31 (Blk. Twp.) 16 (Sur. Rge.) 11W Map No.Operator Skelly OilWell No. 6 Farm J. F. ZornElev. Location C S $\frac{1}{2}$ N $\frac{1}{2}$ NW

990 Ft. From N Line NW1320 Ft. From W Line Quarter1st. Report SEP 30 1953

Completion

Remarks

Spudding Date 9-23-53Drlg. Data Kraft-Prusa PoolAnhy 730 8" @ 747 WOC

County Barton State KansasSec. 31 (Blk. Twp.) 16 (Sur. Rge.) 11W Map No.Operator Skelly OilWell No. 6 Farm J. F. ZornElev. 1903 Location C S $\frac{1}{2}$ N $\frac{1}{2}$ NW990 Ft. From N Line NW1320 Ft. From W Line Quarter

1st. Report

Completion NOV 11 1953Remarks Kraft-Prusa PoolSpudding Date 9-23-53Drilg. Data Oil well TD 3315Anhy 730 8" @ 747 Heeb. 2908Tor. 2924 Doug. 2955 Br. lime 3005Lens. 3017 Qt. 3242 TD 33155" @ 3256 CO to 3315 SSO & 5 gwphPB 3286 sd-frac S/ 28 bo 4 hr.SP 3253 46/ 3243-52 sd-oil-fracS/ 8 bo 2 hr. CO to 3283 P/ 23 bo 4 hr.Comp. 108 bopd

J. G. McGEHEE