


Map No. Ks Sec. 6 Twp. 35 R. 3E
 Well No. 1 Buckley Farm
Marland Oil Company

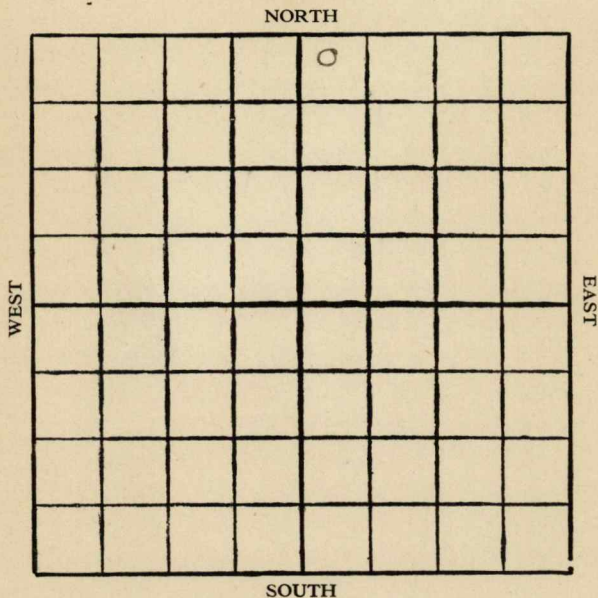

Location

Drilling Remarks

Rig Up

Drilling Remarks

RECORD

Cased in. ft.

Sand

Gas

Oil

Total Depth

PRODUCTION

1st 24 hrs. Nat.

1st 24 hrs. after shot

Gas cu. ft.

Dry Hole


Abandoned

Cowley

Map No. 15 Sec. 6 Twp. 35 R. 3EWell No. 1 FarmBuckley
Marland Oil Company300 Ft. from N. Line

Ft. from S. Line

Ft. from E. Line

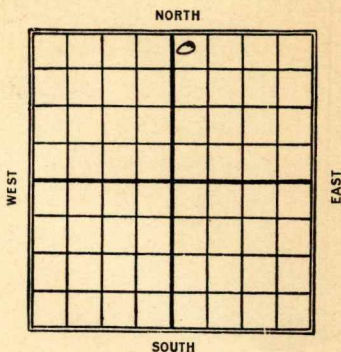300 Ft. from W. Line1926

Date

REPORT

11/10 location
 12/1 Spud
 12/8 Drlg. 410'
 12/15 Drlg. 760'
 12/21 " 1402
 12/29 sand 1520 to 32 - 3m gas
 Drlg 1564

1927

1/5 Drilling 1932
 1/12 " 2290
 1/19 " 2490
 1/26 " 2710
 2/2 " 2955
 2/9 " 3150
 2/16 " 3245
 2/23 " 3425
 3/2 " 3515

3/9 T.D. 3580 in line
 D. & A.

MAP NO. KANSAS SEC. 6 TWP. 35S R. 3E

WELL NO. Buckley

Thorlond COMPANY

CONTRACTOR

SECTION PLAT

_____ FT. FROM N. LINE

_____ FT. FROM S. LINE

_____ FT. FROM E. LINE

_____ FT. FROM W. LINE

RECORD

LOCATION _____

CASED _____ IN. _____ FT.

RIG UP _____

SAND _____

DRILLING AND REMARKS:

GAS _____

OIL _____

TOTAL DEPTH 3580

PRODUCTION

1ST 24 HRS. NAT. _____

1ST 24 HRS. AFTER SHOT _____

GAS _____ CU. FT.

DRY HOLE ☒

ABANDONED ☒

DATE

3/9 192 7

SCOU

County *Cowley*
 Map No. *KANSAS* Sec. *6* Twp. *35* R. *3E*

Well No. *1 Buckley*

Marland Oil Company

Contractor

SECTION PLAT

300 Ft. from N. Line

_____ Ft. from S. Line

_____ Ft. from E. Line

300 Ft. from W. Line

		0	

FIRST REPORTS.

Location _____

Rig up _____

Drilling and Remarks:

Location

RECORD

Cased _____ in., _____ ft.

Sand _____

Gas _____

Oil _____

Total Depth _____

PRODUCTION

1st 24 hrs. Nat. _____

1st 24 hrs. after shot. _____

Gas _____ Cu. Ft.

Dry Hole _____

Abandoned _____

Date

NOV 10 1926

S. J. LEWIS

192

Scout

Map No. KANSAS Sec. 6 Twp. 35 R. 3E

Well No. 1 Buckley

Marland Oil Company

Contractor

SECTION PLAT

300 Ft. from N. Line

_____ Ft. from S. Line

_____ Ft. from E. Line

300 Ft. from W. Line

		0	

COMPLETED

Location _____

Rig up _____

Drilling and Remarks:

TD 3580 in line

IT 17

RECORD

Cased _____ in., _____ ft.

Sand _____

Gas _____

Oil _____

Total Depth _____

PRODUCTION

1st 24 hrs. Nat. _____

1st 24 hrs. after shot _____

Gas _____ Cu. Ft.

Dry Hole _____

Abandoned _____

Date

MAR 9 1927

S. J. LEWIS

192

Scout