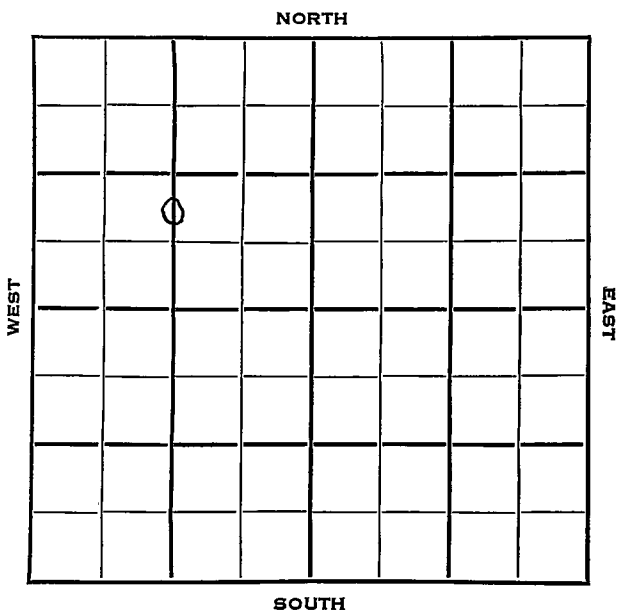


O. W. P. B.

Section 31 Township 16 Range 11 WWell No. # 7 J. F. Zorn• Company Skelly Oil

O. W. P. B.		Barton	KANSAS
SEC.	TWP.	R.	
31	16	11 W	✓
# 7 J. F. Zorn			FARM
COMPANY			
Skelly Oil			
CONTRACTOR			

Kraft-Prusa Pool


_____ Ft. from N. Line

990 _____ Ft. from S. Line

_____ Ft. from E. Line

1320 _____ Ft. from W. Line

C N $\frac{1}{2}$ S $\frac{1}{2}$ NW

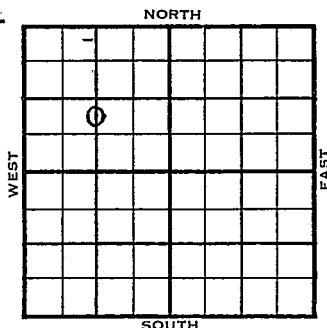

1954	ELEVATION	REPORT
	1898'	
2/3		Spud 1-30-54 8" @ 740' Anhy 734'
2/10		Drilg. 2890'
2/17		Heeb 2894', Tor 2910', Doug 2922', Br li 2990', Lans 3004', At.? 3182', RTD 3298' 5" @ 3188'
2/24		CO 3298' Sd-o-frac
3/3		NR
3/10		"
3/17		Spud 1-30-54 Oil Well TD 3298' 8" @ 740' Anhy 734', Heeb 2894', Tor 2910', Doug 2922', Br lime 2990', Lans 3004', Qt. 3182' TD 3298' 5" @ 3188' CO to 3298 Sd-oil-frac P/22 bopd 5110 15 bw Comp. 13 bopd 13 bw

OVER

COMPLETED

1954
9/29

O. W. P. B.

Oil Well

TD 3240'

Doug Sd 2938', Pre-Cambrian 3182',
5" @ 3188'

TD 3240'

Plug 2989'

52/2956-65, 250A - no show, sq perfs,

59/2938-48, 250A + sd-oil-frac

P 17 BO + 10 BWPD

FIRST REPORT

4

COMPLETED

County **Barton** State **Kansas**Sec. **31** (Blk.) **16** (Sur.) **11W** Map No.Operator **Skelly Oil**Well No. **7** Farm **J. F. Zorn**Elev. Location **C N $\frac{1}{2}$ S $\frac{1}{2}$ NW**

990 Ft. From **S** Line **NW**1320 Ft. From **W** Line Quarter1st. Report **FEB 3 1954**

Completion

Remarks

Spudding Date **1-30-54**

Drilg. Data

Kraft-Prusa Pool**8" @ 740 Any 734****J. G. McGEHEE**

J. G. McGEHEE

O. W. P. B.

County Barton State KansasSec. 31 (Blk.) 16 (Sur.) 11W Map No.Operator Skelly Oil Co.Well No. 7 Farm J. ZornElev. Location C N/2 S/2 NW

COMPLETE
FIRST REPORT

990 Ft. From S Line NW1320 Ft. From W Line Quarter1st. Report SEP 29 1954Completion SEP 29 1954Remarks O.W.P.B.O. W. P. B.

Spudding Date

Drlg. Data Oil Well TD 3240 Kraft-Prusa PoolDoug Sd 2938, Pre-Cambrian 3182, 5" @ 3188TD 3240 Plug 2989, 52/2956-65, 250A - noshow, Sq perfs, 59/2938-48 250A / sd-oilfrac, P 17 BO / 10 BWPD COMP.

FABEN GILSTRAP