


Map No. 2 Sec. 6 Twp. 35 R. 3
Well No. Alma Pit Farm _____ Company _____

NORTH

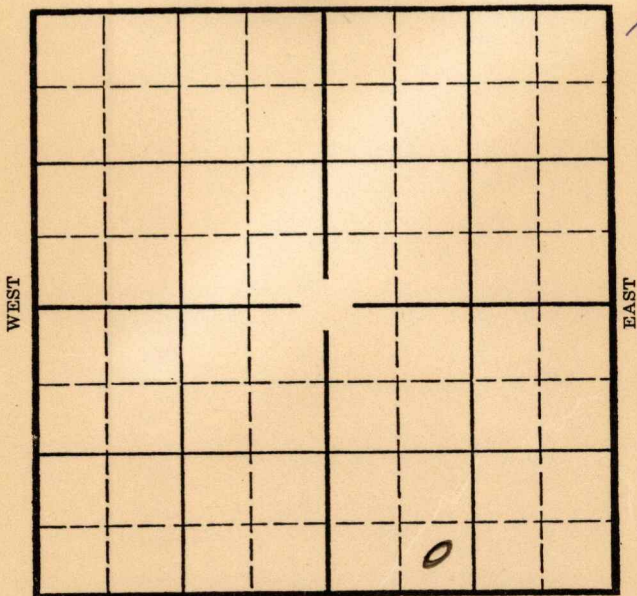

Location _____
Drilling Remarks _____

Rig Up _____
Drilling Remarks _____

RECORD

Cased _____ in. _____ ft.
Sand _____
Gas _____
Oil _____
Total Depth _____

PRODUCTION

1st 24 hrs. Nat. _____
1st 24 hrs. after shot _____
Gas _____ cu. ft. _____
Dry Hole _____
Abandoned _____

KANSAS

Map No. _____ Sec. 6 Twp. 22 R. 2

Well No. L-1 Gregory Farm

Alma Pet

Company

NORTH

Ft. from N. Line

330

Ft. from S. Line

Ft. from E. Line

990

Ft. from W. Line

Elev. 1200

SOUTH

WEST

EAST

REPORT

Date _____

Location

580

15" 130

11 ✓ 1490

" 2800

TP 3431 5" 3431

No Bil 3435 & 3474

log 34.78 Sept 60 96

Typing 50 to 60 Hrs per day
2/6/21

12 3456
 12 3456

TD 39 / 0

log 56 Bol

COMPLETED

Map No. 1 Sec. 6 Twp. 35 R. 3E

Well No. 2 - Gregory

Alma Pitt Company

Contractor

SECTION PLAT

FIRST REPORTS

Ft. from N. Line

330 Ft. from S. Line

Ft. from E. Line

990 Ft. from W. Line

Location ✓

Rig up

Drilling and Remarks:

RECORD

Cased in., ft.

Sand

Gas

Oil

Total Depth

PRODUCTION

1st 24 hrs. Nat.

1st 24 hrs. after shot

Gas Cu. Ft.

Dry Hole

Abandoned

Date

ORVAL MANNSCHRECK

9-12-35 192 Scout

Map No. 1 Sec. 6 Twp. 35 R. 38Well No. 2-GregoryAlma Petroleum Company

Contractor

COMPLETE

SECTION PLAT

Ft. from N. Line

330 Ft. from S. Line

Ft. from E. Line

990 Ft. from W. Line

Location

Rig up

Drilling and Remarks:

60 gts56 bbls

RECORD

Cased in. ft.Sand 3431

Gas

Oil

Total Depth 3478

PRODUCTION

1st 24 hrs. Nat.

1st 24 hrs. after shot

Gas Cu. Ft.

Dry Hole

Abandoned

Date

11-27-35 192

ORVAL MANNSCHRECK

Scout