


Section 7 Township 35 Range 3 E

Well No. #2 Boller

Company Hill & Hill

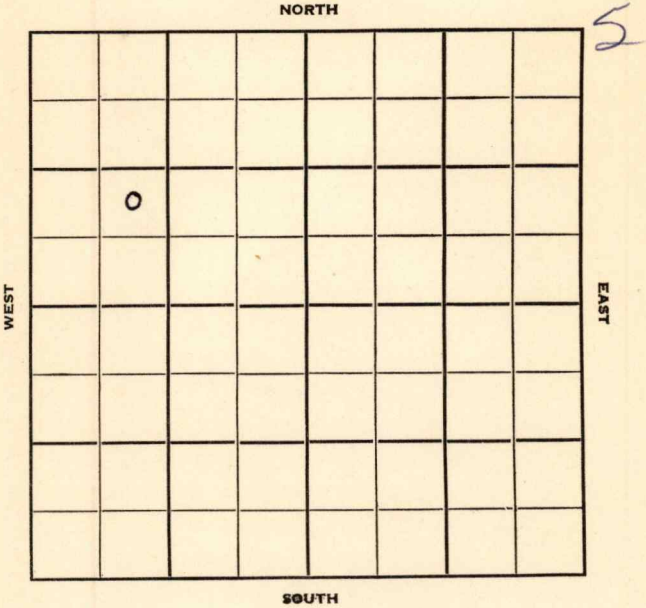

Cowley KANSAS

Sec. 7 Twp. 35 R. 3E

Well No. #2 Boller Farm

Hill & Hill Company

Williams - Contr. Contractor

Murphy Pool


Ft. from N. Line

990' Ft. from S. Line

Ft. from E. Line

990' Ft. from W. Line

NE SW NW

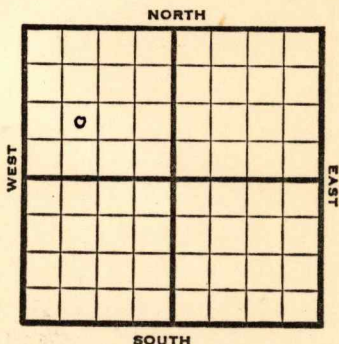

1951

Elev. 1196'

REPORT

1/24

RUR

4/4

Spud 1-30-51

Oil Well TD 3470

10" @ 139

Bart 3433 Sat. 3463

7" @ 3464 TD 3470

S/5 bo 10 gwpd

Hydrafrac Comp. 48 bo 96 bwpd


COMPLETED

County **Cowley** State **Kansas**
 Sec. **7** (Blk. **35** (Sur. **3E** Map No. **3E**)
 (Twp.) (Rge.)

Operator **Hill & Hill**

Well No. **2** Farm **Boller**

Elev. **1196** Location **NE SW NW**

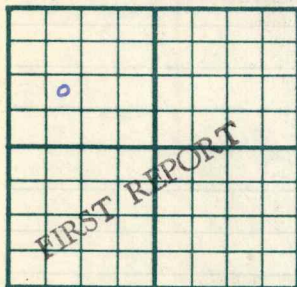

990 Ft. From **S** Line **NW**

990 Ft. From **W** Line **Quarter**

Ist. Report **JAN 24 1951**

Completion

Remarks

Williams - Contr.

Spudding Date

Drlg. Data **Murphy Pool**

RUR

J. E. TYRA

J. E. TYRA