

Company Sunray Oil

14

EAST

0

SOUTH


Butler **KANSAS**Sec. 7 Twp. 29 R. 5EWell No. #5 Perisho FarmSunray Oil CompanyMuddy Creek Pool Contractor

Ft. from N. Line

330 Ft. from S. Line990 Ft. from E. Line

Ft. from W. Line

SW SE SW

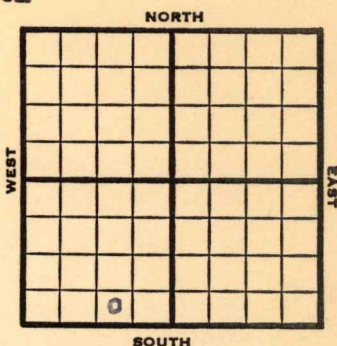

1953

Elev. 1302'

REPORT

4/8

Spud 4-4-53

8" @ 73

Drlg. 810'

5/6

Spud 4-4-53

Oil Well

TD 2818'

8" @ 73'

Bart 2807,

TD 2812

5" @ 2807'

DD 2818 sd-frac Comp. 25 bopd.

COMPLETED

County

State

Kansas

Sec.

7

(Blk.)
(Twp.)

29

(Sur.)
(Rge.)

5E

Map No.

Operator

Sunray Oil

Well No.

5

Farm

Perisho

Elev.

Location

SW SE SW

FIRST REPORT

330

Ft. From

S Line

SW

990

Ft. From

E Line

Quarter

1st. Report

APR

8 19

3

Completion

Remarks

Spudding Date

4-4-53

Drlg. Data

Muddy Creek Pool

8" @ 73 drlg. 810

drlg. 810

[illegible]

J. G. McGEHEE

County Butler State Kansas
 Sec. 7 (Blk. 29 (Sur. 5E Map No.
 (Twp. (Rge.
 Operator Sunray Oil
 Well No. 5 Farm Perisho
 Elev. 1302 Location SW SE SW



330 Ft. From S Line SW
990 Ft. From E Line Quarter

1st. Report

Completion MAY 6 1953

Remarks Muddy Creek Pool

Spudding Date 4-4-53

Drlg. Data Oil well TD 2818
8" @ 73 Bart. 2807 TD 2812 5" @ 2807
DD 2818 sd-frac Comp. 25 bopd

J. G. McGEHEE