


DX 78-1

Section 16 Township 17 Range 14W

Well No. 3 Dryden

Company Rocket Drlg.

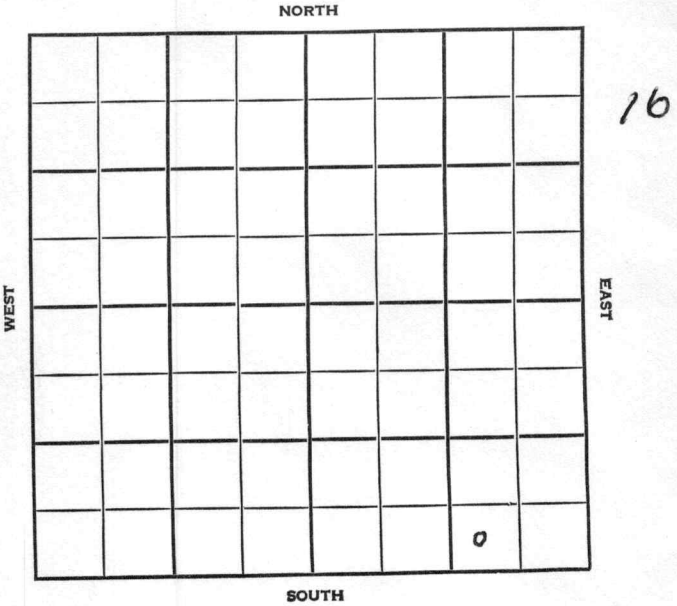

Barton KANSAS


SEC. 16	TWP. 17	R. 14W
------------	------------	-----------

WELL NO. **3 Dryden** FARM
COMPANY

CONTRACTOR **Rocket Drlg.**

Rocket Drlg.
Carroll Pool

_____ Ft. from N. Line
330 _____ Ft. from S. Line
990 _____ Ft. from E. Line
_____ Ft. from W. Line

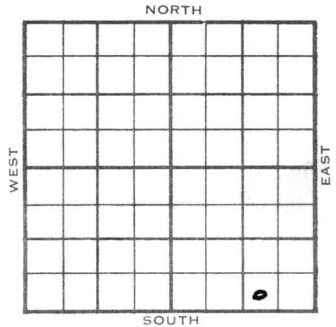

SW SE SE

1954	ELEVATION	REPORT
------	-----------	--------

6/9	<p>Spudding 6-5-54 8" @ 617 Anhy 850 Top. 2808 Heeb 3042 Br. Lime 3107 Lans 3117 DST 3110-43 open 1 hr. Rec 1415' gas 215' . & gcm 65' wtr. Drlg. 3245</p>
7/21	<p>Spud 6-1-54 Oil well TD 3419 8" @ 617 Anhy 850 Top 2808 Heeb 3042 Br. lime 3107 Lans 3117 DST 3110-43, open 1 hr rec 1415' gas 215' 0 & GCM 65' wtr. Arb. 3398 TD 3419' 5" @ 3418 CO to 3412 24/3360-68 9/3368-71 S/5 BOPH 7 hr. S/5 BOPH P/7 BOPH 6 hr. Comp. 100 BOPD</p>

COMPLETED

