


Well No. 52 Wallace Farm

Company

N

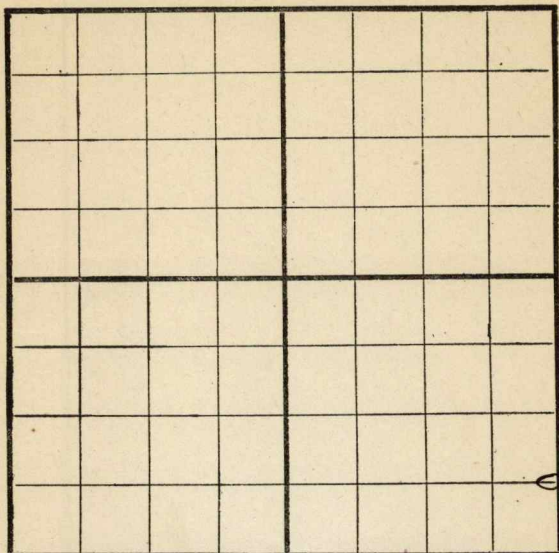

S

Rig Up -----

Drilling Remarks:

PRODUCTION

1st 24 hrs. Nat.-----

1st 24 hrs. after shot-----

Gas ----- cu. ft.

Dry Hole -----

Total Depth-----

Abandoned -----

Well No. 2 Wallace Farm


Last Chance Oil Company

Ft. from N. Line

660 Ft. from S. Line

200 Ft. from E. Line

_____ Ft. from W. Line

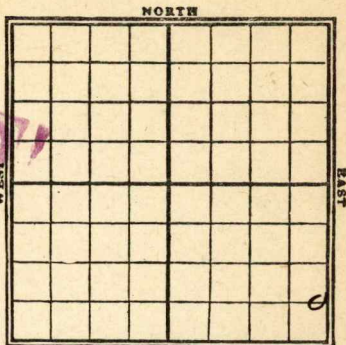

SOUTH

FIRST REPORT

1920
Date

REPORT

310 R^g up.

24	Lovels
----	--------

3/4	c
-----	---

23	✓
----	---

4/2	✓
-----	---

9	Ryging reb
---	------------

5/4	5/9 350
-----	---------

4/8 Dec 1900


6/14	20	2130
------	----	------

7/11	sd 2784-2824	40%
		2500' oil

241 40 lbs. 1st. 24 hrs. after shot.

Map No. K11 Sec. 11 Twp. 29 R. 5Well No. 2 Wallace Farm
Last Chance Oil Company.

NORTH

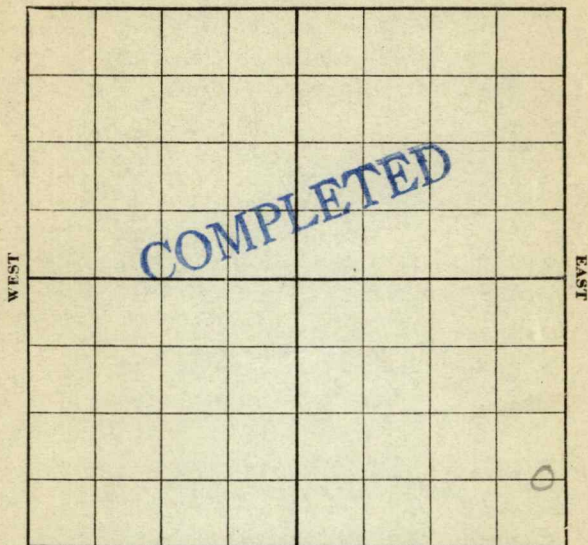

SOUTH

6605200E

RECORD

Location

Cased in., ft.

Rig up

Sand 2784-2824

Drilling and Remarks:

Gas

Oil

Total Depth

PRODUCTION

1st 24 hrs. Nat.

1st 24 hrs. after shot 40 bbls

Gas Cu. Ft.

Dry Hole

Abandoned

Date

Pyle

7/24

192-0

Scout.

Map No. K 11 Sec. 11 Twp. 29 R. 5
 Well No. 2 Wallace
Last Chance Oil Company
 _____ Contractor

SECTION PLAT

_____ Ft. from N. Line

660 Ft. from S. Line200 Ft. from E. Line

_____ Ft. from W. Line

FIRST REPORT

Location _____

Rig up ☒ _____

Drilling and Remarks:

RECORD

Cased _____ in., _____ ft.

Sand _____

Gas _____

Oil _____

Total Depth _____

PRODUCTION

1st 24 hrs. Nat. _____

1st 24 hrs. after shot _____

Gas _____ Cu. Ft.

Dry Hole _____

Abandoned _____

Date

2/10 1920

Pyle

Scout