


Map No. N 11 Sec. 12 Twp. 29 R. 5
 Well No. S. Jackson Farm
S. L. D. & G. Company

N

6

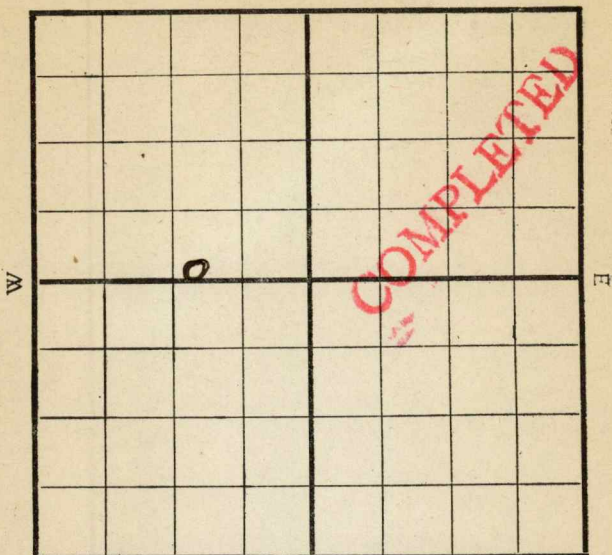

1120 C-200 S.

Location -----

Rig Up -----

Drilling Remarks:

Drilling Remarks:

RECORD

Cased ----- in. ----- ft.

Sand -----

Gas -----

Oil -----

Total Depth -----

PRODUCTION

1st 24 hrs. Nat. -----

1st 24 hrs. after shot -----

Gas ----- cu. ft.

Dry Hole -----


Abandoned -----

Map No. 2.11 Sec. 12 Twp. 29 R. 5Well No. 1 Jackson FarmJ. G. S. & Co. Company

_____ Ft. from N. Line

200 Ft. from S. Line1120 Ft. from E. Line

_____ Ft. from W. Line

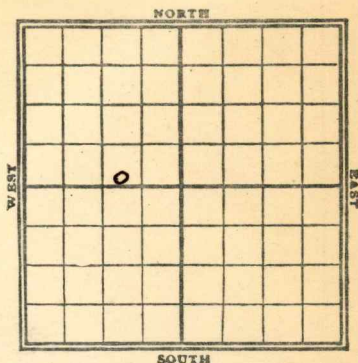

Date

1920

REPORT

7/24Timbers.8/4leg. @ 250'8/10S. D. @ 250'8/29leg @ 1580'9/16256019211/272777-2830slut 30 yds / 70 lb

Map No. K 11 Sec. 12 Twp. 29 R. 5Well No. 1 Jackson
D. H. O. & S. Company

Contractor

SECTION PLAT

Ft. from N. Line

200 Ft. from S. Line1120 Ft. from E. Line

Ft. from W. Line

COMPLETED

Location

Rig up

Drilling and Remarks:

Shot 30 gts

RECORD

Cased _____ in., _____ ft.

Sand 2777-2830

Gas _____

Oil _____

Total Depth _____

PRODUCTION

1st 24 hrs. Nat. _____

1st 24 hrs. after shot 75

Gas _____ Cu. Ft.

Dry Hole _____

Abandoned _____

Date

1/31 191HBP Scout

Map No. K 11 Sec. 12 Twp. 29 R. 5Well No. 1 Jackson FarmS. & S. O. & G. Company.

NORTH

WEST

EAST

SOUTH

1120 E200 S

Location _____

Rig up _____

Drilling and Remarks:

Timbers

RECORD

Cased _____ in., _____ ft.

Sand _____

Gas _____

Oil _____

Total Depth _____

PRODUCTION

1st 24 hrs. Nat. _____

1st 24 hrs. after shot _____

Gas _____ Cu. Ft.

Dry Hole _____

Abandoned _____

Date

Pyle

Scout.

7/24 192 6