


Section 12 Township 29 Range 5E

Well No. 2 Jackson

Company Morrison Producing Co.

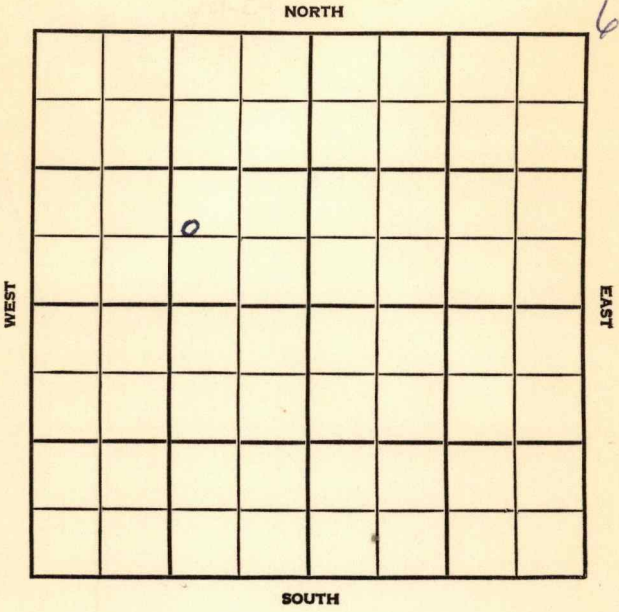

Butler

KANSAS

SEC.	TWP.	R.
12	29	5E


WELL NO. #2 Jackson FARM

COMPANY Morrison Producing Co.

CONTRACTOR Co. Tools.

Fox-Bush Pool

_____ Ft. from N. Line
 782 _____ Ft. from S. Line
 _____ Ft. from E. Line
 1576 _____ Ft. from W. Line

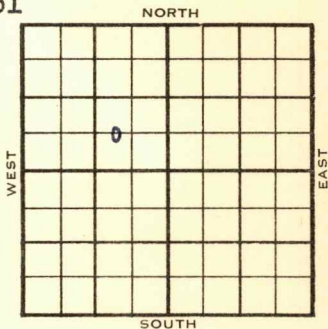

C W $\frac{1}{2}$ SE NW

1954	ELEVATION	REPORT
------	-----------	--------

12/22 Spud 12-20-54
 8" @ 93'
 WOC.

1955
 1/19 Spud 12-20-54 Oil well TD 2823
 8" @ 93 **Bart. 2797** TD 2816
 5 @ 2797 DD 2823 frac.
 Comp. 25 BOPD

COMPLETED

County **Butler** State **Kansas**

Sec. **12** (Blk. Twp.) **29** (Sur. Rge.) **5E** Map No.

Operator **Morrison Producing Co.**

Well No. **2** Farm **Jackson**

Elev. Location **C W $\frac{1}{2}$ SE NW**

782 Ft. From **S** Line **NW**

1576 Ft. From **W** Line Quarter

Ist. Report **DEC 22 1954**

Completion

Remarks

Co. tools

Spudding Date **12-20-54**

Fox-Bush Pool

Drlg. Data

8" @ 93 WOC

FABEN GILSTRAP

County Butler State Kansas

Sec. 12 (Blk. 29 (Sur. 5E Map No.
(Twp.) (Rge.)

Operator Morrison Producing Co.

Well No. 2 Farm Jackson

Elev. _____ Location C W $\frac{1}{2}$ SE NW



782 Ft. From S Line NW

1576 Ft. From W Line Quarter

1st. Report

Completion JAN 19 1955

Remarks Fox-Bush Pool

Co. tools

Spudding Date 12-20-54

Drlg. Data Oil well TD 2823

8" @ 93 Bart. 2797 TD 2816 5" @ 2797

DD 2823 frac Comp. 25 bopd