

Map No. T. 11 Sec. 12 Twp. 29 R. 5


Well No. 2 Jackson Farm
The Kirby Oil Company

200 Ft. from N. Line

_____ Ft. from S. Line

_____ Ft. from E. Line

600 Ft from W. Line

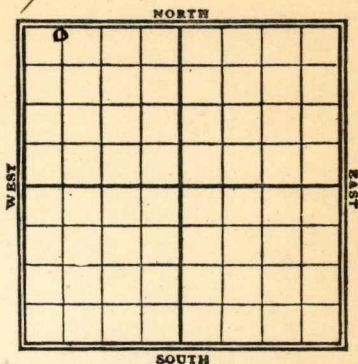

Date 7-26

REPORT

Run up

COMPLETED

1921

1/27 2777-98 - 5,000,000
gals.

Map No. K 11 Sec. 12 Twp. 29 R. 5
 Well No. 2 Jackson
The Derby Oil Company
 _____ Contractor

SECTION PLAT

200 Ft. from N. Line
 _____ Ft. from S. Line
 _____ Ft. from E. Line
660 Ft. from W. Line

| | | | |
|---|--|--|--|
| 0 | | | |
| | | | |
| | | | |
| | | | |

COMPLETED

Location _____
 Rig up _____
 Drilling and Remarks:

RECORD

Cased _____ in., _____ ft.
 Sand 2777-98
 Gas _____
 Oil _____
 Total Depth _____

PRODUCTION

1st 24 hrs. Nat. _____
 1st 24 hrs. after shot _____
 Gas 5,000,000 Cu. Ft.
 Dry Hole _____
 Abandoned _____

Date

1/27 1911 JHP Scout

Map No. K11 Sec. 12 Twp. 29 R. 5
 Well No. 2 Jackson
The Kirby Oil Company
 Contractor

SECTION PLAT

| | | |
|---|--|--|
| 0 | | |
| | | |
| | | |
| | | |

200 Ft. from N. Line
 _____ Ft. from S. Line
 _____ Ft. from E. Line
660 Ft. from W. Line

FIRST REPORT

Location _____
 Rig up _____
 Drilling and Remarks:

RECORD

Cased _____ in., _____ ft
 Sand _____
 Gas _____
 Oil _____
 Total Depth _____

PRODUCTION

1st 24 hrs. Nat. _____
 1st 24 hrs. after shot _____
 Gas _____ Cu. Ft
 Dry Hole _____
 Abandoned _____

Date

9/26 _____
 _____ 1920 _____

Pyle

Scout