


Section 12 Township 29 Range 5 E

Well No. # 3 Jackson

Company Morrison Production

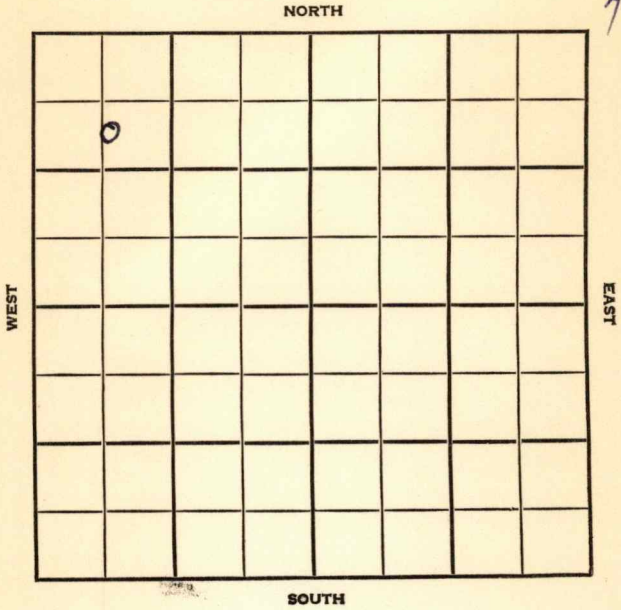

Butler **KANSAS**

SEC.	TWP.	R.
12	29	5E

WELL NO. **3 Jackson** FARM

COMPANY **Morrison Production**

CONTRACTOR


Fox -Bush Pool

_____ Ft. from N. Line

1640 _____ Ft. from S. Line

_____ Ft. from E. Line

750 _____ Ft. from W. Line

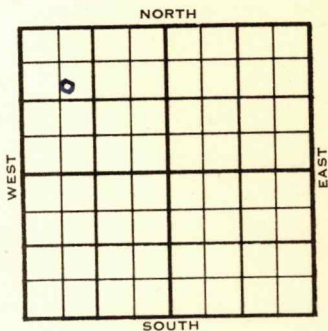

SE NW NW

	ELEVATION	REPORT
1955	1383'	

1/5 Spud 1-2-55
8" @ 90', WOC

2/2 Spud 1-2-55 Oil well TD 2830
8" @ 90 **Bart 2799** TD 2816
5" @ 2801 DD 2830
Comp. 15 BOPD 5 BW

COMPLETED

County **Butler** State **Kansas**

Sec. **12** (Blk. Twp.) **29** (Sur. Rge.) **5E** Map No.

Operator **Morrison Production**

Well No. **3** Farm **Jackson**

Elev. Location **SE NW NW**

0					
FIRST REPORT					

1640 Ft. From **S** Line **NW**
750 Ft. From **W** Line Quarter

1st. Report **JAN 5 1955**

Completion

Remarks

Spudding Date **1-2-55**

Drilg. Data **Fox-Bush Pool**

8" @ 90 WOC

FABEN GILSTRAP