

Butler

KANSAS


SECTION 12 TOWNSHIP 29 RANGE 5 E

WELL NO. #5 Jackson

COMPANY Morrisn Prod. Co.

NORTH

H

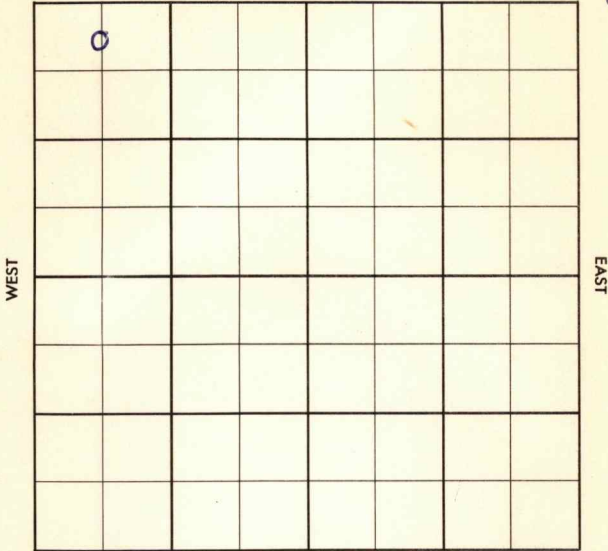

SOUTH

Butler

KANSAS

SEC. 12	TWP. 29	R. 5E
------------	------------	----------

WELL NO. #5 Jackson FARM

COMPANY Morrison Prod. Co.

CONTRACTOR Co. tools


Fox-Bush
243 Ft. from N. Line

Ft. from S. Line

Ft. from E. Line

754 Ft. from W. Line

C N $\frac{1}{2}$ NW NW

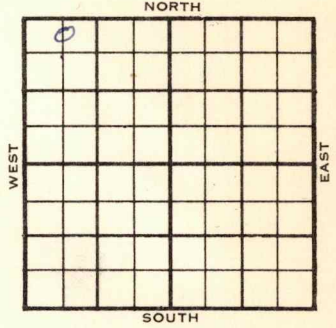

1956	ELEVATION 1388 GF	REPORT
------	----------------------	--------

1-5 Comm. 1-4-56
 2-1 8 5/8" @ 97/100
 5 1/2" @ 2808
 DD 2834
 FU 1000' fluid (1/3 wtr.)
 Comp. 25 bopd, 300 BW
 Bart 2806'
 TD 2804

COMPLETED

County Butler Elev. 1388 GF
 Sec. 12 Twp. 29 Rge. 5E
 Company Morrison Prod. Co.
 Farm Name Jackson No. 5

TOPS	DEPTH	LOG	DATUM
Anh.			
Tp.			
H.			
Tr.			
Dg.			
Bl.			
L.			
K.C.			
B.K.C.			
Ce.			
C.			
M.			
M.			
K.			
Mz.			
Mo.			
V.			
S.			
S.			
A.			
R.			
Pe.			
G.			
T.D.			

Loc. in Sec. C N $\frac{1}{2}$ NW NW
243' NL
754' WL

Geol. _____
 Contr. _____
Co. tools
 Pool _____
Fox-Bush

0	
FIRST REPORT	
JAN	5 '66

Date Comm. 1-4-56

Co.

Lse.

No.

Sec.

T.

R.

1388 GF

County Butler

Elev. 1386 DF

Sec. 12 Twp. 29 Rge. 5E

Company Morrison Prod. Co.

Farm Name Jackson No. 5

Co.

Lse.

No.

Sec.

T.

R.

TOPS	DEPTH	LOG	DATUM
Anh.			
Tp.			
H.			
Tr.			
Dg.			
Bl.			
L. <u>Bart</u>	<u>2806</u>		<u>1420</u>
K.C.			
B.K.C.			
Ce.			
C.			
M.			
M.			
K.			
Mz.			
Me.			
V.			
S.			
S.			
A.			
R.			
Pe.			
G.			
TD.	<u>2814</u>		

Loc. in Sec. _____

C N $\frac{1}{2}$ NW NW

243' NL

754' WL

Geol. _____

Contr. Co. tools

Pool Fox-Bush

0		
COMPLETE		

COMPLETE

Date Comm. 1-4-56

FEB 1 1956

8 5/8" @ 97/100 5 1/2" @ 2808 DD 2834

FU 1000' fluid (1/3 wtr.)

Comp. 25 bopd 300 bw