

WEST

EAST

SOUTH

COMPLETED

Drilling Remarks:

Rig Up-----

Drilling Remarks:

RECORD

Cased _____ in. _____ ft.

Sand _____

Gas _____

Oil _____

Total Depth -----

PRODUCTION

1st 24 hrs. Nat. -----

1st 24 hrs. after shot_ _ _ _ _

Gas _____ cu. ft.

Dry Hole_____

Abandoned_ _ _ _ _

Map No. 72 Sec. 17 Twp. 29 R. 5


Well No. 8 Jackson Farm
Sturley Oil Company

Ft. from N. Line

200 Ft. from S. Line

Ft. from E. Line

200 Ft. from W. Line

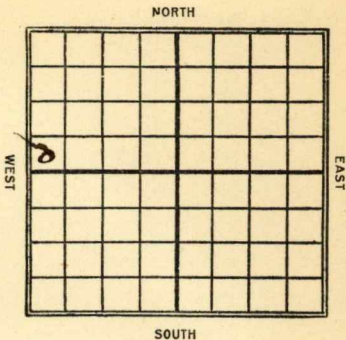

COMPLETED

Date

REPORT

1/22
1/3 Tap sand 2781'
1/15 2781-2826 -
 Shot 55 gals -
 340 lbs.

Map No. 11 Sec. 12 Twp. 29 R. 5Well No. 8 Jackson FarmDerby Oil CompanyDate Started _____ Ft. from N. S 200 E. W 200 lineNORTH Kansas

WEST

O FIRST REPORT

EAST

SOUTH

Cased _____ In. _____ Ft.

Sand _____

Pay { Gas _____
Oil _____

Total Depth _____

Production Remarks

Condition of Well on this date _____

Tap sand 27 8'

M. A. BENEAR

Scout

Map No. R11 Sec. 12 Twp. 29 R. 5Well No. P. Jackson

_____ Company

_____ Contractor

Completed

SECTION PLAT

0			

_____ Ft. from N. Line

200' Ft. from S. Line

_____ Ft. from E. Line

200' Ft. from W. Line

Location _____

Rig up _____

Drilling and Remarks:

sand { 2781'
 2826'
shot 25 qb
making 240
lbs

RECORD

Cased _____ in., _____ ft.

Sand _____

Gas _____

Oil _____

Total Depth _____

PRODUCTION

1st 24 hrs. Nat. _____

1st 24 hrs. after shot _____

Gas _____ Cu. Ft.

Dry Hole _____

Abandoned _____

Date

1/15 1922 M.B. Scout