

# KANSAS


FORM 51 5M 11-44 PETROL

Barton County

Section 32 Township 16 Range 11W

Well No. #7 Hitschman Est.

Company Black-Marshall

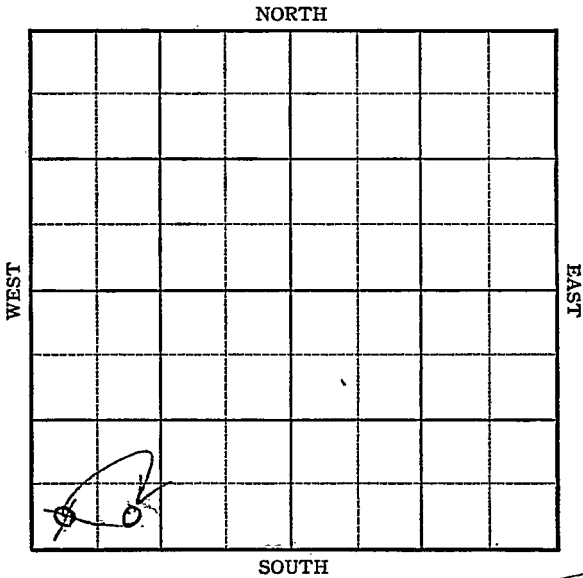

Sec. 32 Twp. 16 R. 11W

Well No. #7 Hitschman Est. Farm

Black-Marshall Company


Kraft-Prusa

Ft. from N. Line

330 Ft. from S. Line

Ft. from E. Line

990  
~~330~~ Ft. from W. Line

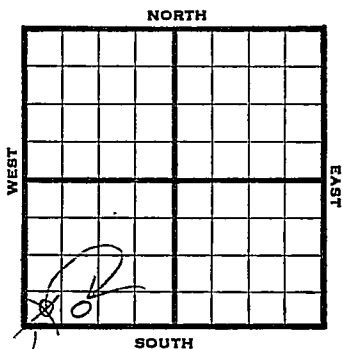

~~SW~~ SE SW SW

1946 1923 REPORT

El ev.

- 6/26 Location
- 7/3 8" @ 280  
Drlg 2780'
- 7/9 Topeka 2730                      Lans 3090  
BKC 3367                              Sand 3375  
TD 3377-5" @ 3375'              RUST
- 7/16                      "                      "                      "
- 7/23 Swb 38 oil in 3 hrs
- 7/31 Douglas 3025  
Lans. 3090  
5" @ 3375  
TD 3377  
Perf. Douglas  
Pump 547 Pot.  
Grav. 42.0

COMPLETED

KANSAS

Kansas Pool Name Kraft-PrusaMap No. 33 Sec. 32 Twp. 16 R. 11WWell No. 7 Hirschman Est.Black-Marshall

Company

## FIRST REPORT

Contractor

SW/C

## SECTION PLAT


\_\_\_\_\_ Ft. from N. Line

330 Ft. from S. Line

\_\_\_\_\_ Ft. from E. Line

330 Ft. from W. Line

Barton County

Location X

Rig up \_\_\_\_\_

Drilling and Remarks:

## RECORD

Cased \_\_\_\_\_ in., \_\_\_\_\_ ft.

Sand \_\_\_\_\_

Gas \_\_\_\_\_

Oil \_\_\_\_\_

Total Depth \_\_\_\_\_

## PRODUCTION

1st 24 hrs. Nat. \_\_\_\_\_

1st 24 hrs. after shot \_\_\_\_\_

Gas \_\_\_\_\_ Cu. Ft.

Dry Hole \_\_\_\_\_

Abandoned \_\_\_\_\_

Date

JUN 26 1946 19

S. J. LEWIS

Scout

55 Kansas Pool Name Kraft-Prusa

~~KANSAS~~ Sec. 32 Twp. 16 R. 11W

Well No. 7 Hitschman Est.

Black-Marshall Company

**CORRECTION** Contractor

SE SW SW

SECTION PLAT

         Ft. from N. Line

330 Ft. from S. Line

         Ft. from E. Line

990 Ft. from W. Line

6*			

Barton County

Location                                 

Rig up                                 

Drilling and Remarks:

Reported          SW/C

RECORD

Cased          in.,          ft.

Sand                                 

Gas                                 

Oil                                 

Total Depth                         

PRODUCTION

1st 24 hrs. Nat.                         

1st 24 hrs. after shot                         

Gas                                  Cu. Ft.

Dry Hole                                 

Abandoned                                 

Date

JUL 1 0 1946 19

S. J. LEWIS Scout

**KANSAS** Kansas Pool Name Kraft-Prusa Pool

Map No. \_\_\_\_\_ Sec. 32 Twp. 16 R. 11W

Well No. 7 Hirschman Est.

Black-Marshall Company

**COMPLETED**

Contractor

SE SW SW

*E11923*  
SECTION PLAT

\_\_\_\_\_ Ft. from N. Line

330 Ft. from S. Line

\_\_\_\_\_ Ft. from E. Line

990 Ft. from W. Line

0			

Barton County

Location \_\_\_\_\_

Rig up \_\_\_\_\_

Drilling and Remarks:

*Doug las 3025*

*Line 3096*

*5-103375*

*Prof Doug las*

*Pump 517 PD*

*420 SW*

**RECORD**

Cased \_\_\_\_\_ in., \_\_\_\_\_ ft.

Sand \_\_\_\_\_

Gas \_\_\_\_\_

Oil \_\_\_\_\_

Total Depth 3277

**PRODUCTION**

1st 24 hrs. Nat. \_\_\_\_\_

1st 24 hrs. after shot \_\_\_\_\_

Gas \_\_\_\_\_ Cu. Ft.

Dry Hole \_\_\_\_\_

Abandoned \_\_\_\_\_

Date

JUL 3 1 1946 19

S. J. LEWIS Scout