


Section 32 Township 16 Range 11-W

Well No. #1 Rous

Company G. W. Hinkle

NORTH Prusa Pool

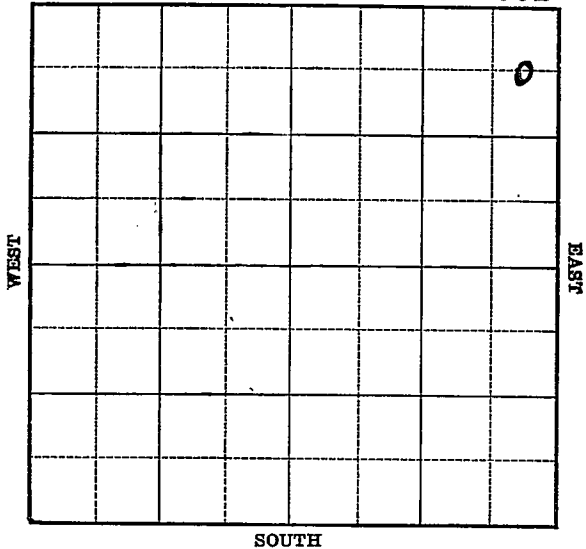

200

Sec. 32 Twp. 16 R. 11-W

Well No. #1 Rous Farm

G. W. Hinkle Company

(Prusa)


660 Ft. from N. Line

Ft. from S. Line

330 Ft. from E. Line

Ft. from W. Line

Elev. 1890

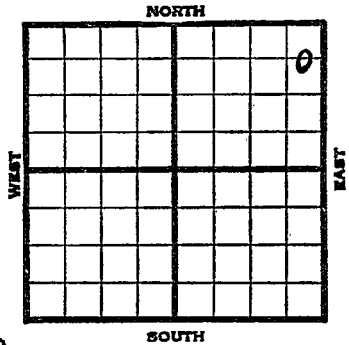

1940	REPORT
2/14	Cellar.
2/23	Derrick.
2/29	10" - 108' WOC.
3/8	Anhy 740' Drlg. 2012'
3/14	Lans. 3061' Cong. 3336'
	Coring 3352'
3/20	Cong. 3336'
	T.D. 3404'
	No shows.
	ABANDONED

Map No. 55 Sec. 32 Twp. 16 R. 11WWell No. 1 RousG. W. Hinkle

Company

Contractor

**FIRST REPORT
C E L NE NE**660 Ft. from N. Line Ft. from S. Line330 Ft. from E. Line Ft. from W. Line**SECTION PLAT**

PRUSA POOLLocation Rig up

Drilling and Remarks:

Cellar**RECORD**Cased in., ft.Sand Gas Oil Total Depth **PRODUCTION**1st 24 hrs. Nat. 1st 24 hrs. after shot Gas Cu. Ft.Dry Hole Abandoned

Date

FEB 14 1940 19S. J. LEWIS Scout

Barton KANSAS

Map No. 55 Sec. 32 Twp. 16 R. 11WWell No. 1 KoušG. W. Hinkle

Company

Contractor

ABANDONED

C E L NE NE

SECTION PLAT

			o

660 Ft. from N. Line

_____ Ft. from S. Line

330 Ft. from E. Line

_____ Ft. from W. Line

PRUSA POOL

Location _____

Rig up _____

Drilling and Remarks:

*Comp 3336**No shows*

RECORD

Cased _____ in., _____ ft.

Sand _____

Gas _____

Oil _____

Total Depth 3404

PRODUCTION

1st 24 hrs. Nat. _____

1st 24 hrs. after shot _____

Gas _____ Cu. Ft.

Dry Hole _____

Abandoned _____

Date

MAR 20 1940 19

S. J. LEWIS Scout