


Map No. K14 Sec. 33 Twp. 25 R. 5

Well No. 03 Stokes

Company Empire

Contractor C. E. Ross

NORTH

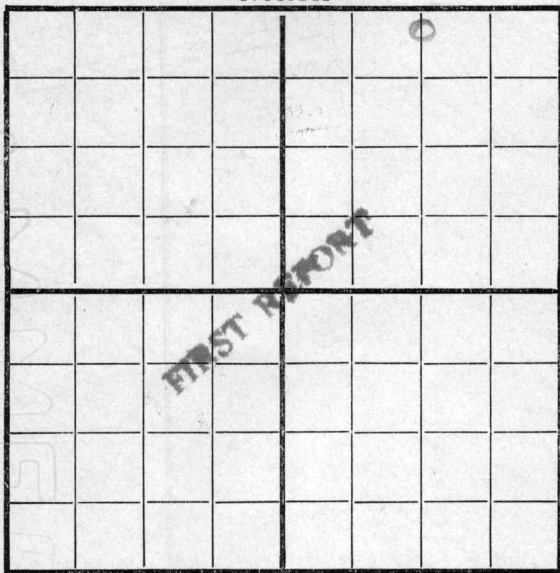

SOUTH

Location _____

Rig up _____

Drilling and Remarks:

150'S
1320' W
Spudding

RECORD

Cased _____ in., _____ ft.

Sand _____

Gas _____

Oil _____

Total Depth _____

PRODUCTION

1st 24 hrs. Nat. _____

1st 24 hrs. after shot _____

Gas _____ Cu. Ft.


Dry Hole _____

Abandoned _____

Date

7/24 1918 By Scout

Map No. _____ Sec. 33 Twp. 25 R. 5
 Well No. 63 Stokes
 _____ Company
 _____ Contractor

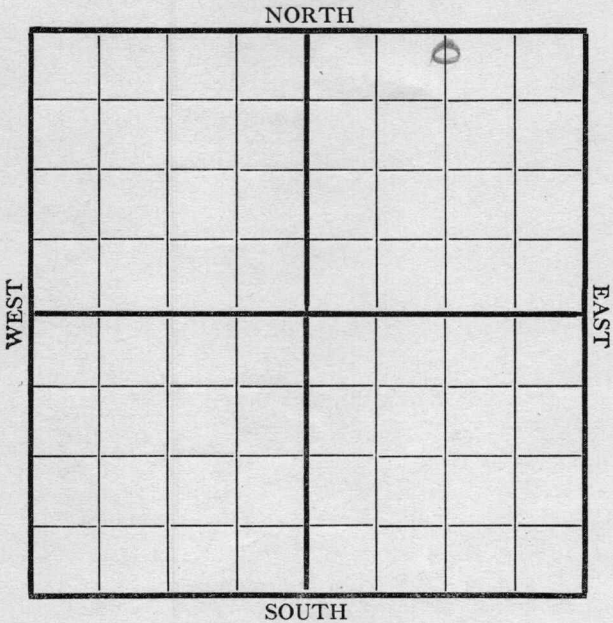

Location 150' N
1320' W
 Rig up _____
 Drilling and Remarks:

fishing tools @ 600'

RECORD

Cased _____ in., _____ ft.
 Sand _____
 Gas _____
 Oil _____
 Total Depth _____

PRODUCTION

1st 24 hrs. Nat. _____
 1st 24 hrs. after shot _____
 Gas _____ Cu. Ft.
 Dry Hole _____
 Abandoned _____

Date 7/31 1918 Cyler Scout


Map No. _____ Sec. 33 Twp. 25 R. 5

Well No. 63 Stokes

Empire Company

Contractor _____

NORTH

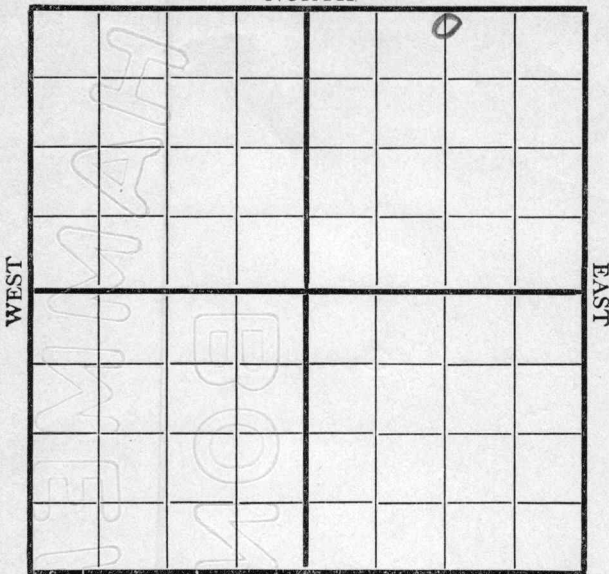

SOUTH

150 N
Location 1370 W

Rig up _____

Drilling and Remarks:

*fishing
for tools
@ 600'*

RECORD

Cased _____ in., _____ ft.

Sand _____

Gas _____

Oil _____

Total Depth _____

PRODUCTION

1st 24 hrs. Nat. _____

1st 24 hrs. after shot _____

Gas _____ Cu. Ft.

Dry Hole _____

Abandoned _____

Date

8/7 1918

Cyle Scout

Map No. _____ Sec. 33 Twp. 25 R. 5

Well No. 63 Stokes


Empire Company

Contractor

NORTH

WEST

EAST

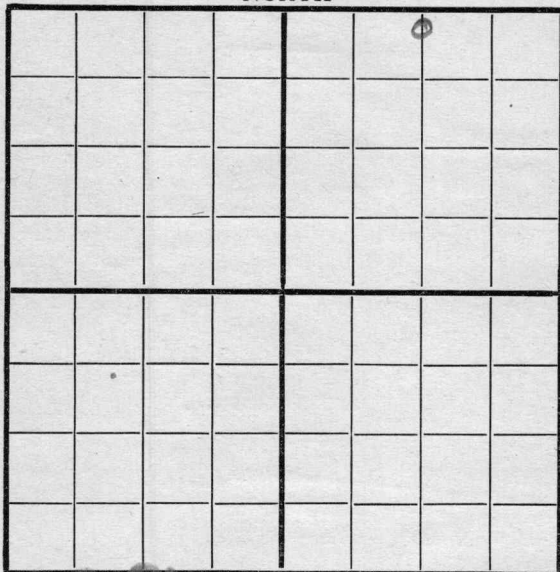

SOUTH

150 N

Location 1320W

Rig up _____

Drilling and Remarks:

D. D @
600'

RECORD

Cased _____ in., _____ ft.

Sand _____

Gas _____

Oil _____

Total Depth _____

PRODUCTION

1st 24 hrs. Nat. _____

1st 24 hrs. after shot _____

Gas _____ Cu. Ft.

Dry Hole _____

Abandoned _____

Date 8/3

1918

C. G. A. Scout


Map No. ¹⁰⁰³ K14 Sec. 33 Twp. 25 R. 5

Well No. 63 Stokes

Empire State Company

C. E. Ross Contractor

NORTH

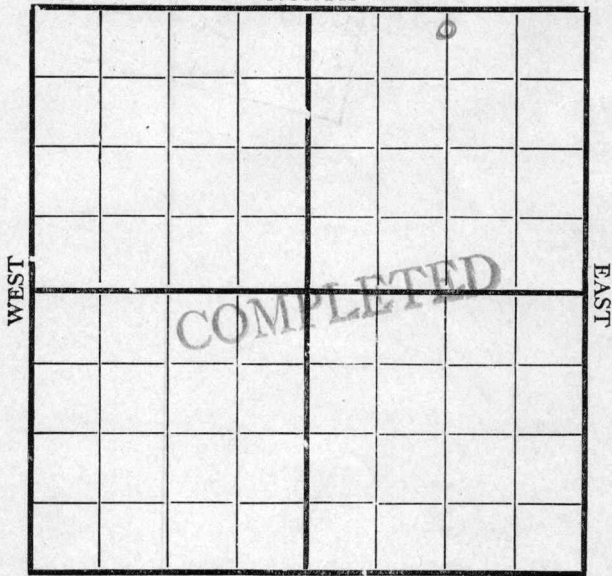

SOUTH

150' N - 1320' E

Location -----

Rig up -----

Drilling and Remarks: -----

RECORD

Cased ----- in., ----- ft.

Sand -----

Gas -----

Oil -----

Total Depth -----

PRODUCTION

1st 24 hrs. Nat. -----

1st 24 hrs. after shot -----

Gas ----- Cu. Ft.

Dry Hole 775 -----

Abandoned -----

Date

7/20 1918 Oyle Scout