


CORNISH FARM NO. 1. Sec. 3, Twp. 25 S., Range 13 E.

HATFIELD & TEETER owners. GREENWOOD COUNTY. 3-25-13E

SW corner of NW $\frac{1}{4}$ .

Soil	22 - 22
Lime	8 - 30
Shale	18 - 48
Lime	5 - 53
Shale	70 - 123
Lime	2 - 125
Shale	107 - 232
Flint	8 - 240
Brown shale	10 - 250
Lime	34 - 284
Shale	108 - 392
Blue lime	8 - 400
Grey sand	8 - 408
Shale	5 - 413
White sand	17 - 430
Lime	22 - 452
Shale	(13 - 465
	(12 - 477
White lime	51 - 528
Sandy shale	82 - 610
Shale	85 - 695
Brown Lime	16 - 711
Shale	4 - 715
Lime	20 - 735
Shale	25 - 760
Blue lime	81 - 841
Shale	4 - 845
White lime	20 - 865
Black lime	4 - 861 (Salt water)
White lime	47 - 908
Shale	6 - 914
White lime	10 - 924
Shale	24 - 948
Grey lime	22 - 970
White shale	120 - 1090
Shale	55 - 1145
Black lime	3 - 1148
White lime	77 - 1225
Shale	35 - 1260
Lime	3 - 1263
Shale	10 - 1273
Sand	7 - 1280
Shale	35 - 1315
Lime	3 - 1318
Shale & shells	257 - 1575 (Miss. Lime)
Lime	25 - 1600 (Water)

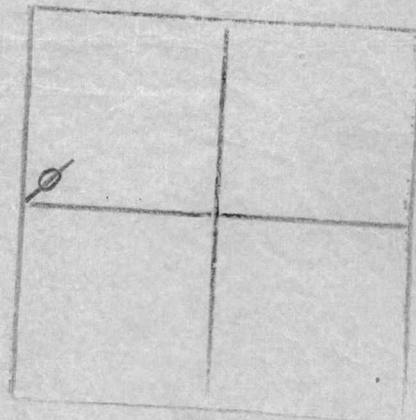

Dry and abandoned.  
1575 feet of 4-7/8" casing.