


Map No. H 14 Sec. 33 Twp. 25 R. 5

Well No. 68 Stokes
Empire Company

Contractor

NORTH

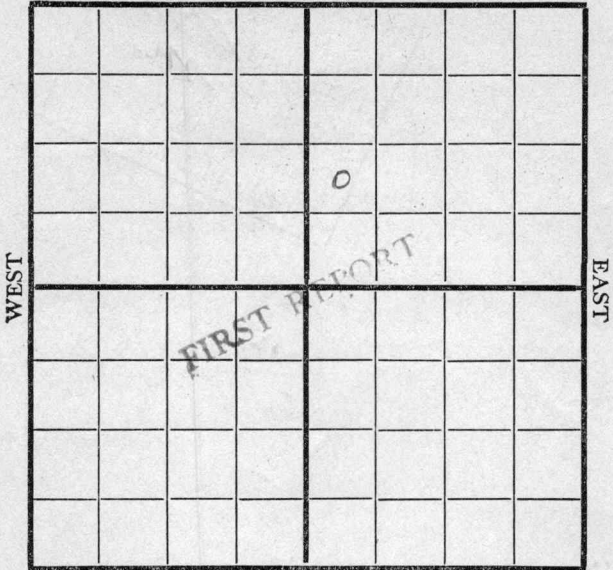

990 S SOUTH 330 W

RECORD

Location _____

Cased _____ in., _____ ft.

Rig up _____

Sand _____

Drilling and Remarks:

Gas _____

Oil _____

Total Depth _____

PRODUCTION

1st 24 hrs. Nat. _____

1st 24 hrs. after shot _____

Gas _____ Cu. Ft.

Dry Hole _____

Abandoned _____

Date

Pyle

1919

Scout

6/27

Map No. K14 Sec. 33 Twp. 25 R. 5

Well No. 68 Stokes

Empire Company

Contractor

SECTION PLAT

----- Ft. from N. Line

990 Ft. from S. Line

----- Ft. from E. Line

330 Ft. from W. Line

| | | | |
|--|--|---|--|
| | | | |
| | | 6 | |
| | | | |
| | | | |

COMPLETED

Location -----

Rig up -----

Drilling and Remarks:

RECORD

Cased ----- in., ----- ft.

Sand 2402-2411

Gas -----

Oil -----

Total Depth -----

PRODUCTION

1st 24 hrs. Nat. 16.5 bbls

1st 24 hrs. after shot -----

Gas ----- Cu. Ft.

Dry Hole -----

Abandoned -----

Date

9/19 1919

Pyle

Scout