

Woodson


DX 78-1

KANSAS

Section 29 Township 25 Range 14E

Well No. #1 Corkery "B"

Company M.A. Corkery

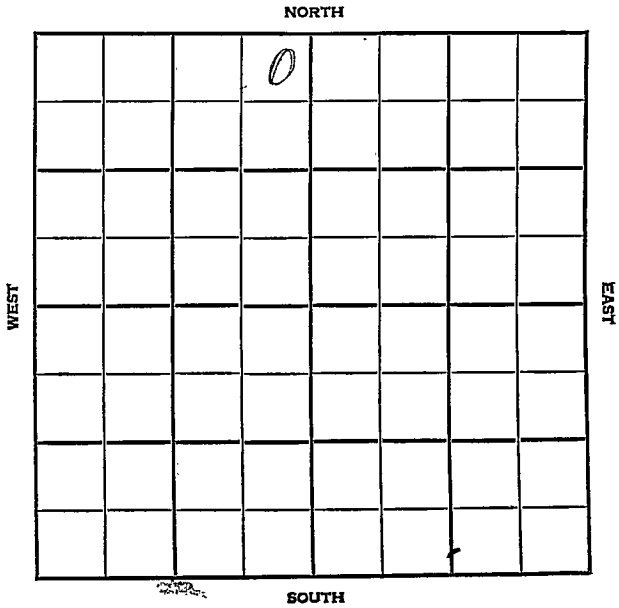

County Woodson Elev. _____
 Sec. 29 Twp. 25 Rgs. 14E
 Company M. A. Corkery
 Farm Name Corkery "B" No. 1

TOPS	DEPTH	LOG	DATUM	Loc. in Sec.
Anh.				NE NE NW
TP.				
H.				
Tr.				
Dg.				
BL.				
L.				Geol.
K.C.				Contr.
B.K.C.				H.J. Uhl Dril
Ce.				
C.				Pool
M.				Batesville
M.				
K.				
Mz.				
Me.				
V.				
S.				
S.				
A.				
R.				
PE.				
G.				
T.D.				

Date Comm. Spd. 11-12-56
8" @ 100 w/65, drhg. 904



34

County	Woodson	Elev.	
Sec.	29	Twp.	25
Rge.	14E		
Company	H. A. Corkery		
Farm Name	Corkery "E"	No.	1

TOPS	DEPTH	LOG	DATUM	Loc. in Sec.
Anh.				NE NE NW
Tr.				
H.				
Tr.				
Dg.				
Bl.				
L.				
K.C.				Geol.
B.K.C.				Contr.
Ce.	Barl	1403		H.J. Uhl Drl
C.				
M.				Pool
M.				Batesville
K.				
Mz.				
Mo.				
V.				
S.				
S.				
A.				
R.				
PE.				
G.				
TD.	1435	1407		

Geol.

Contr.

H.J. Uhl Drl

Pool

Batesville

COMPLETE

Date Comm. spd. 11-12-56

8" @ 100 w/65, drdg. 904 NOV 28 '55 Pipe

set. DEC 5 '56 ✓ DEC '56 5 1/2 @ 1403

DEC 13 '56 PB 1414 to FVAC. DEC 26 '56

POP JAN '57 ✓ JAN '57

P 3 Bopd + lots wtr.