

## FORM 51 5M 10-41 PETROL

Section 33 Township 16 Range 11-W

Well No. #4 Harzman

Company Republic Natural Gas

Kraft Prusa Pool NORTH

A 10x10 grid map. The left edge is labeled 'WEST', the right edge is labeled 'EAST', and the bottom edge is labeled 'SOUTH'. A small circle is located in the 7th row from the top and the 2nd column from the left.


# KANSAS Barton

Sec. 33 Twp. 16 R. 11-W

Well No. #4 Harzman Farm

Republic Natural Gas Company

(Kraft Prusa Pool)

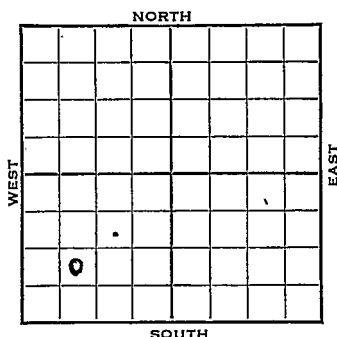

Ft. from N. Line

990 Ft. from S. Line

Ft. from E. Line

990 Ft. from W. Line

*Elv. 1883*

1942

## REPORT

9/16

Derrick

9/23

8" @ 282 Drlg 2000

9/30

TD 3339' Arb. <sup>3332</sup>~~3336~~ 5" - 3336

RUST

10/7

Arb. 3332 (Corrected)

5" - 3332 T.D. 3335

4500 acid H.F.W.

10/14

PB 3300

Lans 3045

10 shots 3056-61

5 " 3065-68

5 " 3130-33

10 " 3234-37 500 acid

Swb 12 water per hr.

10/21

Arb. 3332 Water 5" @ 3332

Lans. 3045

T.D. 3335

Perforated Lans

Water

**ABANDONED**

Map No. 55 Sec. 33 Twp. 16 R. 11WWell No. 4 HarzmanRepublic Natural Gas Company**FIRST REPORT**

Contractor

NE SW SW

**SECTION PLAT**

|  |  |  |  |
|--|--|--|--|
|  |  |  |  |
|  |  |  |  |
|  |  |  |  |
|  |  |  |  |

       Ft. from N. Line990 Ft. from S. Line       Ft. from E. Line990 Ft. from W. Line**KRAFT PRUSA POOL**Location                     Rig up                     

Drilling and Remarks:

Derri ck

**RECORD**Cased            in.,            ft.Sand                     Gas                     Oil                     Total Depth                     **PRODUCTION**1st 24 hrs. Nat.                     1st 24 hrs. after shot                     Gas                      Cu. Ft.Dry Hole                     Abandoned                     

Date

SEP 16 1942 19S. J. LEWIS Scout

Barton

KANSAS

Map No. 55 Sec. 33 Twp. 16 R. 11WWell No. 4 Harzman

Republic Natural Gas Company

ABANDONED Contractor

NE SW SW

SECTION PLAT

|   |  |  |  |
|---|--|--|--|
|   |  |  |  |
|   |  |  |  |
|   |  |  |  |
| 0 |  |  |  |

Ft. from N. Line

990 Ft. from S. Line

Ft. from E. Line

990 Ft. from W. Line

KRAFT PRUSA POOL

Location

Rig up

Drilling and Remarks:

*Cor & 3332 Water.*  
*5" @ 3332*  
*Water*

RECORD

Cased \_\_\_\_\_ in., \_\_\_\_\_ ft.

Sand \_\_\_\_\_

Gas \_\_\_\_\_

Oil \_\_\_\_\_

Total Depth 3335

PRODUCTION

1st 24 hrs. Nat. \_\_\_\_\_

1st 24 hrs. after shot \_\_\_\_\_

Gas \_\_\_\_\_ Cu. Ft.

Dry Hole \_\_\_\_\_

Abandoned \_\_\_\_\_

Date

OCT 21 1942

19

S. J. LEWIS Scout