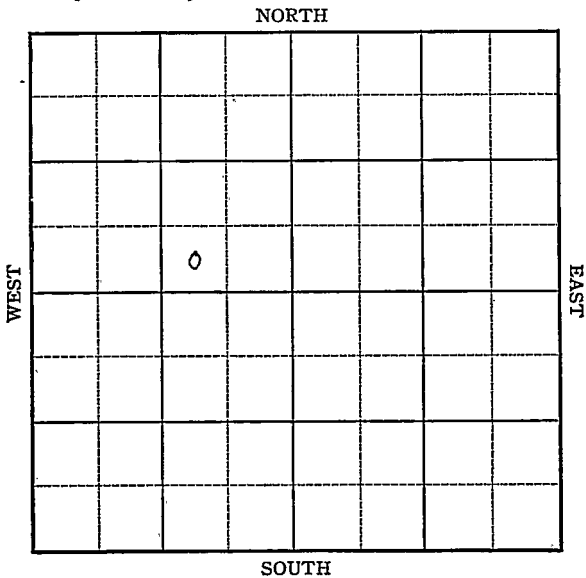


Section 33 Township 16 Range 11-WWell No. #4 Hartzman (*Hartzman*)Company She 11
(Pru sa)

Map No. _____ Sec. 33 Twp. 16 R. 11WWell No. 4 Hartzman _____

Shell _____

Company _____

~~FIRST REPORT~~

Contractor _____


SECTION PLAT

SW SE NW

_____ Ft. from N. Line

330 Ft. from S. Line990 Ft. from E. Line

_____ Ft. from W. Line

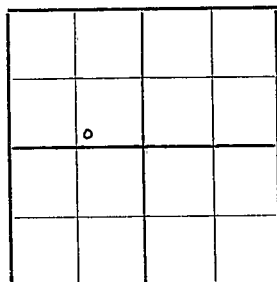

PRUSA POOL

Location X _____

Rig up _____

Drilling and Remarks: _____

RECORD

Cased _____ in., _____ ft.

Sand _____

Gas _____

Oil _____

Total Depth _____

PRODUCTION

1st 24 hrs. Nat. _____

1st 24 hrs. after shot _____

Gas _____ Cu. Ft.

Dry Hole _____

Abandoned _____

Date

JUL 23 1941 19S. J. LEWIS Scout

Map No. _____ Sec. 33 Twp. 16 R. 11WWell No. 4 Harzman

_____ Shell _____ Company

_____ COMPLETED _____ Contractor

SW SE NW

_____ Ft. from N. Line

330 Ft. from S. Line990 Ft. from E. Line

_____ Ft. from W. Line

PRUSA POOL

SECTION PLAT

Location _____

Rig up _____

Drilling and Remarks:

Ar 83347
" @ 83348.
6000 acid
Pump 240 Bbl.
430 ft

RECORD

Cased _____ in., _____ ft.

Sand _____

Gas _____

Oil _____

Total Depth 8361

PRODUCTION

1st 24 hrs. Nat. _____

1st 24 hrs. after shot _____

Gas _____ Cu. Ft.

Dry Hole _____

Abandoned _____

Date

AUG 27 1941 19 S. J LEWIS Scout