

Barton

KANSAS


Section 33 Township 16 Range 11-W

Well No. #5 Harzman

Company Shell

Prusa Pool

NORTH

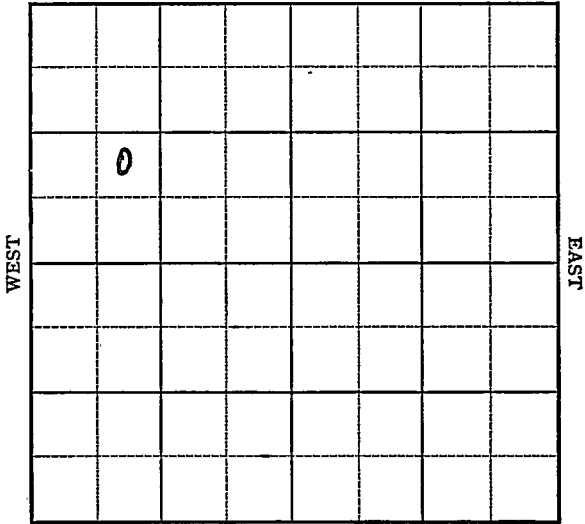

SOUTH

Barton

KANSAS

Map No. K-55 Sec. 33 Twp. 16 R. 11WWell No. 5 HarzmanShell CompanyFIRST REPORT Contractor

NE SW NW

SECTION PLAT

o			

 Ft. from N. Line990 Ft. from S. Line Ft. from E. Line990 Ft. from W. Line

PRUSA POOL

Location Rig up

Drilling and Remarks:

Cellar

RECORD

Cased in., ft.Sand Gas Oil Total Depth

PRODUCTION

1st 24 hrs. Nat. 1st 24 hrs. after shot Gas Cu. Ft.Dry Hole Abandoned

Date

OCT 15 1941 19S. J. LEWIS

Scout

Barton

KANSASMap No. K-11 Sec. 33 Twp. 16 R. 11WWell No. 5 HarzmanShe 11

Company

COMPLETED

Contractor

NE SW NW

SECTION PLAT

6			

 Ft. from N. Line990 Ft. from S. Line Ft. from E. Line990 Ft. from W. Line

PRUSA POOL

Location Rig up

Drilling and Remarks:

*Per X-3351**4" @ 3352**4000 acid**Echo Prod. 2811**43 9/16***RECORD**Cased in., ft.Sand Gas Oil Total Depth 3356**PRODUCTION**1st 24 hrs. Nat. 1st 24 hrs. after shot Gas Cu. Ft.Dry Hole Abandoned

Date

NOV 12 1941

19

S. J. LEWIS Scout