
KANSAS
Form 51—5M—7-39—Palace

Barton

Section 33, Township 16 Range 11-W

Well No. #1 Janke

Company Derby Oil

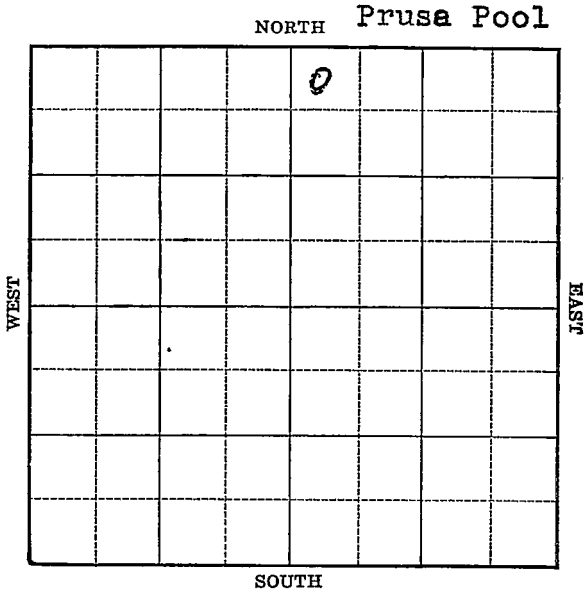

FORM 252-A 5M 7-40 PETRO KANSAS Barton

Sec. 33 Twp. 16 R. 11-W

Well No. #1 Janke Farm

Derby Oil Company


(Prusa)

330 Ft. from N. Line

_____ Ft. from S. Line

_____ Ft. from E. Line

330 Ft. from W. Line

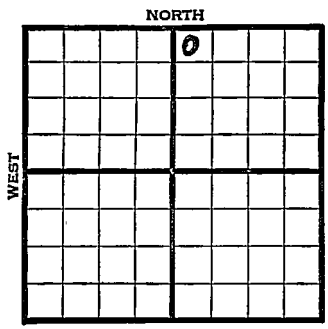

Elev. 1922

1940	REPORT
10/9	7" - 725' WOC.
10/17	Drlg. 2860'
10/24	Lans. 3083' Arb. 3351-52' T.D.
	4" - 3351' RUST.
10/31	T.D. 3362' Swab 218 bbls. in 3
	hours.
11/6	Arb. 3351'
	4" - 3351'
	T.D. 3362'
	Depthograph potential 4663 bbls.
	Maximum 3000 bbls.
	COMPLETED

Form 26—200 Bks.—1-40—Palace Barton KANSAS

Map No. 55 Sec. 33 Twp. 16 R. 11W

Well No. 1 Janke

Derby Oil Company

Contractor

FIRST REPORT

NW NE

330 Ft. from N. Line


_____ Ft. from S. Line

_____ Ft. from E. Line

330 Ft. from W. Line

PRUSA POOL

SECTION PLAT

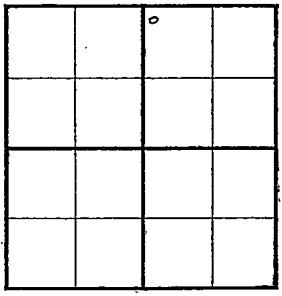

Location _____

Rig up _____

Drilling and Remarks:

7" - 725

WOC

RECORD

Cased _____ in., _____ ft.

Sand _____

Gas _____

Oil _____

Total Depth _____

PRODUCTION

1st 24 hrs. Nat. _____

1st 24 hrs. after shot _____

Gas _____ Cu. Ft.

Dry Hole _____

Abandoned _____

Date

OCT 9 1940 19____

S. I. LEWIS Scout

Form 26—200 Bks.—1-40—Palace Barton

KANSAS

Map No. 55 Sec. 33 Twp. 16 R. 11W

Well No. 1 Janke

Derby Oil Company

Contractor

COMPLETED

NW NE

330 Ft. from N. Line


_____ Ft. from S. Line

_____ Ft. from E. Line

330 Ft. from W. Line

PRUSA POOL

SECTION PLAT

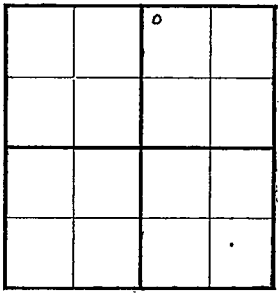

Location _____

Rig up _____

Drilling and Remarks:

Cr & 3351

4" @ 3351

Depth Pa 3463

Plug 3000

RECORD

Cased _____ in., _____ ft.

Sand _____

Gas _____

Oil _____

Total Depth 3362

PRODUCTION

1st 24 hrs. Nat. _____

1st 24 hrs. after shot _____

Gas _____ Cu. Ft.

Dry Hole _____

Abandoned _____

Date

NOV 6 1940 19

S. J. LEWIS Scout