

KANSAS

Form 51-5M-7-39-Palace


Butler

Section 8 Township 28 Range 7-E

Well No. #6 DeMoss "A"

Company Rex & Morris

NORTH **Brandt Pool**

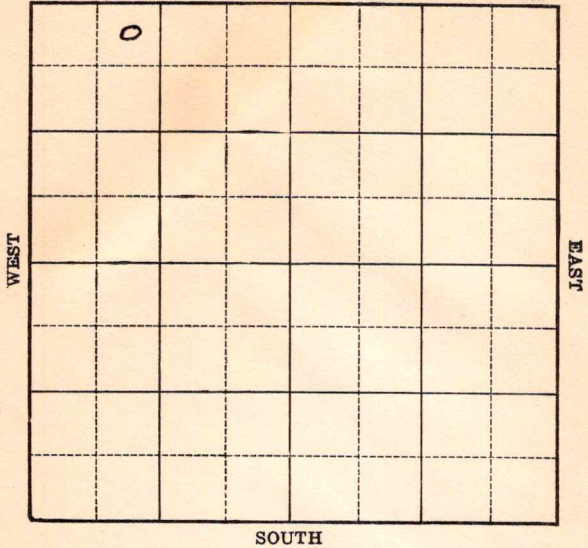

Sec. 8 Twp. 28 R. 7-E

Well No. #6 DeMoss "A" Farm

Rex & Morris Company

(Brandt)


330 Ft. from N. Line

_____ Ft. from S. Line

_____ Ft. from E. Line

990 Ft. from W. Line

Elev. 1417

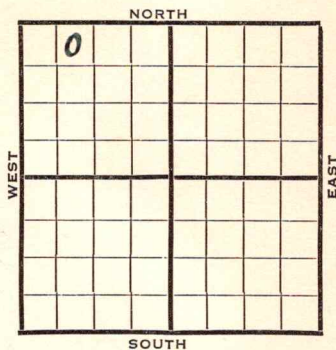

1940	REPORT
6/5	Drlg. 730'
6/13	10" - 1620' Drlg. 1745'
6/20	8" - 2138' Drlg. 2265'
6/27	Bart. 2640-84' T.D. 6" - 2640'
	Shot 100 qts. 2660-82' H.F.O. in 1½ hours.
7/3	" " " "
7/10	Bart. 2640'
	6" - 2640'
	T.D. 2684'
	Shot 100 qts. 2660-82'
	Pump 27 bbls.

COMPLETED

Map No. 10 Sec. 8 Twp. 28 R. 7E

Well No. 6 DeMoss "A"

Rex & Morris Company

Contractor

FIRST REPORT

NE NW NW

SECTION PLAT

330 Ft. from N. Line

o			

_____ Ft. from S. Line

_____ Ft. from E. Line

990 Ft. from W. Line

BRANDT POOL

Location _____

RECORD

Rig up _____

Cased _____ in., _____ ft.

Drilling and Remarks:

Sand _____

Dr 1 g. 730

Gas _____

Oil _____

Total Depth _____

PRODUCTION

1st 24 hrs. Nat. _____

1st 24 hrs. after shot _____

Gas _____ Cu. Ft.

Dry Hole _____

Abandoned _____

Date

JUN 5 1940

S. J. LEWIS

Scout

Map No. 10 Sec. 8 Twp. 28 R. 7E

Well No. 6 DeMoss "A"

Rex & Morris Company

Contractor

COMPLETE

SECTION PLAT

NE NW NW

0			

330 Ft. from N. Line

_____ Ft. from S. Line

_____ Ft. from E. Line

990 Ft. from W. Line

BRANDT POOL

Location _____

Rig up _____

Drilling and Remarks:

Bart 2640
6" @ 2640
100g to 2660-82.
Pump 27 1/2

RECORD

Cased _____ in., _____ ft.

Sand _____

Gas _____

Oil _____

Total Depth 2684

PRODUCTION

1st 24 hrs. Nat. _____

1st 24 hrs. after shot _____

Gas _____ Cu. Ft.

Dry Hole _____

Abandoned _____

Date

JUL 10 1940 19

S. J. LEWIS Scout