

Butler


KANSAS

FORM 51 5M 2-38 TPCO.

Section 8 Township 28 Range 7-E

Well No. #1 Farner

Company Rex & Morris

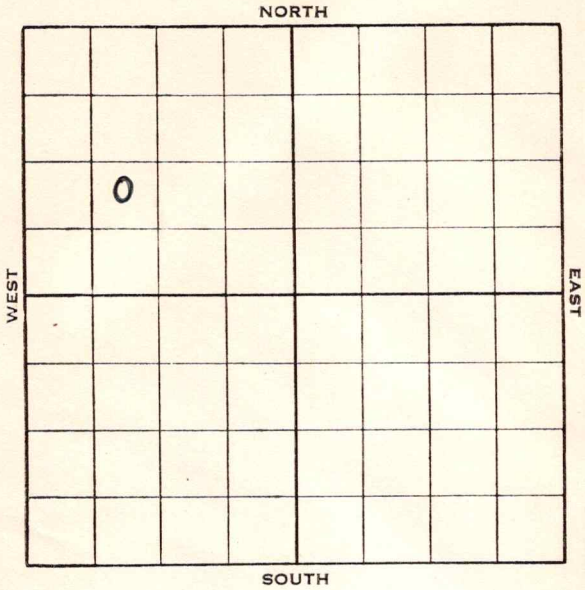

Sec. 8 Twp. 28 R. 7-E


Well No. #1 Farner Farm  
Rex & Morris Company

         Ft. from N. Line

990 Ft. from S. Line

         Ft. from E. Line

990 Ft. from W. Line

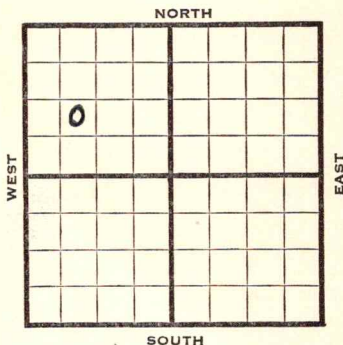

**Elev. 1396'.**

1938	REPORT
9/7	Machine.
	15" - 80'. 12" - 747'.
	10" - 1556'. Drlg. 1560'.
9/16	<b>K. C. 2000'.</b> 8" - 2118'.
	S. O. 2155-65'. Dlg. 2425'.
9/23	6" - 2636'. <b>Bart. 2636-72'.</b>
	Shot 120 qts. 1300' oil.
9/28	6" - 2636'.
	<b>Bart. 2636'.</b>
	T. D. 2672'.
	Shot 120 qts.
	40 bbls. oil.
	<b>COMPLETED</b>

Map No. 10 Sec. 8 Twp. 28 R. 7E

Well No. 1 Farner

Rex & Morris Company

Contractor

FIRST REPORT

SECTION PLAT

NE SW NW

\_\_\_\_\_ Ft. from N. Line

990 Ft. from S. Line

\_\_\_\_\_ Ft. from E. Line

990 Ft. from W. Line

0			

Location \_\_\_\_\_

Rig up \_\_\_\_\_

Drilling and Remarks:

Mach.  
 15" - 80'  
 12" - 747  
 10" - 1556  
 Drlg. 1560

RECORD

Cased \_\_\_\_\_ in., \_\_\_\_\_ ft.

Sand \_\_\_\_\_

Gas \_\_\_\_\_

Oil \_\_\_\_\_

Total Depth \_\_\_\_\_

PRODUCTION

1st 24 hrs. Nat. \_\_\_\_\_

1st 24 hrs. after shot \_\_\_\_\_

Gas \_\_\_\_\_ Cu. Ft.

Dry Hole \_\_\_\_\_

Abandoned \_\_\_\_\_

Date

SEP 7 - 1938

19

ORVAL MANNSCHRECK

Scout

