


Section 8 Township 28 Range 7-E

Well No. #2 Farner


Company Rex & Morris

NORTH Miscellaneous

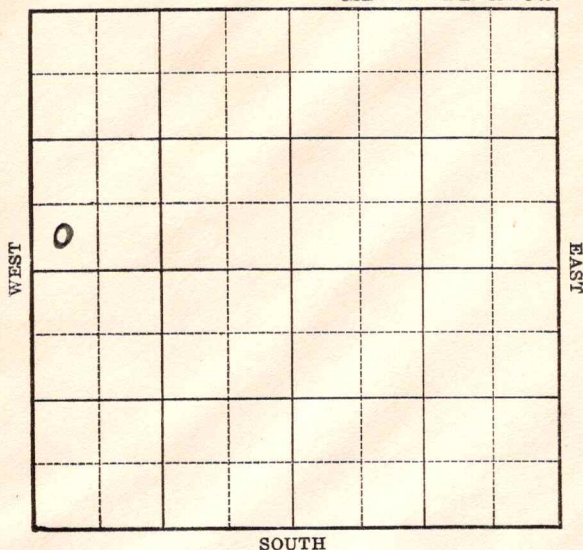

KANSAS**Butler**Sec. 8 Twp. 28 R. 7-EWell No. #2 Farner FarmRex & Morris Company

(Miscellaneous)

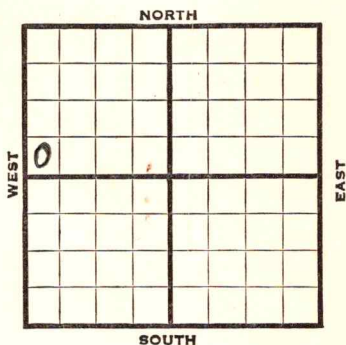0 Ft. from N. Line330 Ft. from S. Line Ft. from E. Line330 Ft. from W. Line**Elev. 1391**

1939	REPORT
1/11	R.U.M.
1/20	15" - 85'. Drlg. 625'.
1/27	12" - 748'. T. D. 1540'.
	Rng. 8".
2/3	10" - 1534'. 8" - 2147'.
	Drlg. 2200'.
2/10	K. C. 1990'. Bart. 2636'.
	T. D. 2661' S. O. 6" - 2627'.
	WOC.
2/17	Shot 110 qts.
2/23	" "
3/1	6" - 2627'
	Bart. 2636'
	T. D. 2661'
	Shot 110 qts.
	Est. 30 bbls.
	COMPLETED

Butler

KANSAS

Map No. 10 Sec. 8 Twp. 28 R. 7EWell No. 2 FarnerRex & Morris

Company

Contractor

FIRST REPORT

SW NW

Ft. from N. Line

330

Ft. from S. Line

Ft. from E. Line

330

Ft. from W. Line

SECTION PLAT

0			

MISCELLANEOUS

Location _____

Rig up _____

Drilling and Remarks:

RUM

RECORD

Cased _____ in., _____ ft.

Sand _____

Gas _____

Oil _____

Total Depth _____

PRODUCTION

1st 24 hrs. Nat. _____

1st 24 hrs. after shot _____

Gas _____ Cu. Ft.

Dry Hole _____

Abandoned _____

Date

JAN 11 1939 19

H. D. Hatfield Scout

Butler

KANSAS

Map No. 10 Sec. 8 Twp. 28 R. 7EWell No. 2 FarnerRex & Morris Company

Contractor

COMPLETED

SW NW

SECTION PLAT

0			

 Ft. from N. Line330 Ft. from S. Line Ft. from E. Line330 Ft. from W. Line

MISCELLANEOUS

Location Rig up

Drilling and Remarks:

Shot 110 gtsEST 30 bbls

RECORD

Cased 6 in., 2627 ft.Sand Bart 2636Gas Oil Total Depth 2661

PRODUCTION

1st 24 hrs. Nat. 1st 24 hrs. after shot Gas Cu. Ft.Dry HoleAbandoned

Date

MAR 1 - 1939

19

H. D. Hatfield Scout