


Kansas *Butler Co*

Map No. _____ Sec. *9* Twp. *28* R. *7*

Well No. *1 Leman* Farm _____

John Herron Company _____

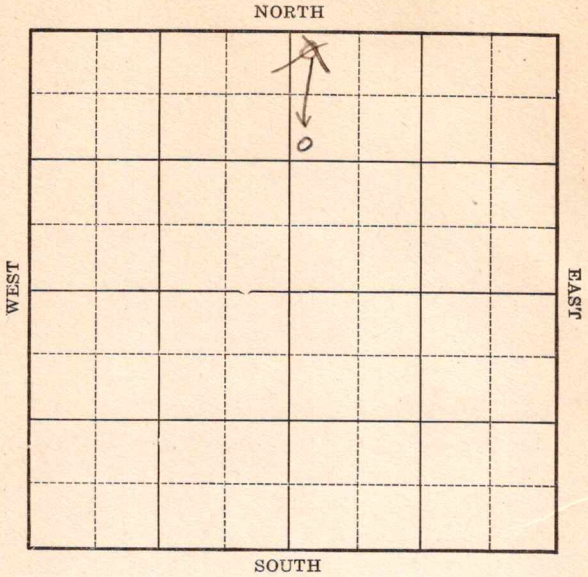

Location _____

Rig Up _____

Drilling Remarks _____

Drilling Remarks _____

RECORD

PRODUCTION

Cased _____ in. _____ ft.

Sand _____

Gas _____

Oil _____

Total Depth _____

1st 24 hrs. Nat. _____

1st 24 hrs. after shot _____

Gas _____ cu. ft.

Dry Hole _____

Abandoned _____

Butler Co

Map No. Kansas Sec. 9 Twp. 28 R. 7

Well No. 1 Leman Farm


John Rogers Company
MARLAND OIL

1120
~~200~~ Ft. from N. Line

..... Ft. from S. Line

..... Ft. from E. Line

200 Ft. from W. Line

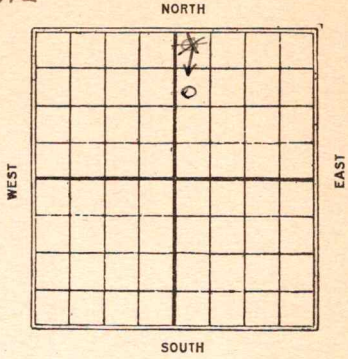

Date	REPORT
<u>1925</u>	
<u>11/13</u>	<u>Location</u>
<u>11/19</u>	_____
<u>11/27</u>	<u>Big</u>
<u>12/3</u>	<u>spud</u>
<u>12/10</u>	_____
<u>12/17</u>	<u>Drlg 765'</u>
<u>12/23</u>	<u>Running 12" 1025'</u>
<u>12/31</u>	<u>Drlg 1250'</u>
<u>1926</u>	
<u>1/8</u>	<u>Drlg 1550'</u>
<u>1/14</u>	<u>fishing trailer 1600'</u>
<u>1/20</u>	_____
<u>1/27</u>	_____
<u>2/4</u>	_____
<u>2/10</u>	_____
<u>2/17</u>	_____
<u>2/24</u>	<u>Drlg 1710</u>
<u>3/5</u>	<u>" 2025</u>
<u>3/10</u>	<u>" 2215</u>
<u>3/18</u>	<u>" 2703</u>
<u>3/25</u>	<u>Sandy shale 2666-2706</u>
	<u>H.F.W. Dlg 2750</u>

4/1 - Dlg - 3015

4/7 - " 3020

4/14 - Top line 274° Dlg 3253.

4/21 - Abandoned 3330

Bother Co

Map No. *K10* KANSAS Sec. *9* Twp. *28* R. *7*

Well No. *1 Lemon*

John Herron Company

Contractor

FIRST REPORTS

SECTION PLAT

200 Ft. from N. Line

_____ Ft. from S. Line

_____ Ft. from E. Line

200 Ft. from W. Line

		o	

Location _____
 Rig up _____
 Drilling and Remarks: _____

RECORD

Cased _____ in., _____ ft.
 Sand _____
 Gas _____
 Oil _____
 Total Depth _____

PRODUCTION

1st 24 hrs. Nat. _____
 1st 24 hrs. after shot _____
 Gas _____ Cu. Ft.
 Dry Hole _____
 Abandoned _____

Date

NOV 13 1925

CHAS. L. SHERWOOD
 Scout

Butcher Co

Map No. *K10 KANSAS* Sec. *9* Twp. *29* R. *7*

Well No. *Leman*
Mallard oil Co Company

Contractor

CORRECTION

SECTION PLAT

1120 Ft. from N. Line
Ft. from S. Line
Ft. from E. Line
200 Ft. from W. Line

		⊕	

Location

Rig up

Drilling and Remarks:

chg location & ownership to above.

RECORD

Cased _____ in., _____ ft.
Sand _____
Gas _____
Oil _____
Total Depth _____

PRODUCTION

1st 24 hrs. Nat. _____
1st 24 hrs. after shot _____
Gas _____ Cu. Ft.
Dry Hole _____
Abandoned _____

Date
NOV 19 1925

CHAS. L. SHERWOOD

192 Scout

K10 KANSAS Sec. 9 Twp. 28 R. 7

Well No. 1 Lemans

MacLard Oil Co Company

Contractor

COMPLETED

SECTION PLAT

1120 Ft. from N. Line

Ft. from S. Line

Ft. from E. Line

200 Ft. from W. Line

		o	

ABANDONED

Location

Rig up

Drilling and Remarks:

2706' Dry 2706-2716' AFH 3325-3330'

DLW

RECORD

Cased in., ft.

Sand

Gas

Oil

Total Depth 3330'

PRODUCTION

1st 24 hrs. Nat.

1st 24 hrs. after shot

Gas Cu. Ft.

Dry Hole

Abandoned

Date

APR 21 1926

CHAS. L. SHERWOOD

192

Scout