


Woods on

KANSAS

Section 31 Township 25 Range 14-E


Well No. 1 Tipton

Company Petty et al

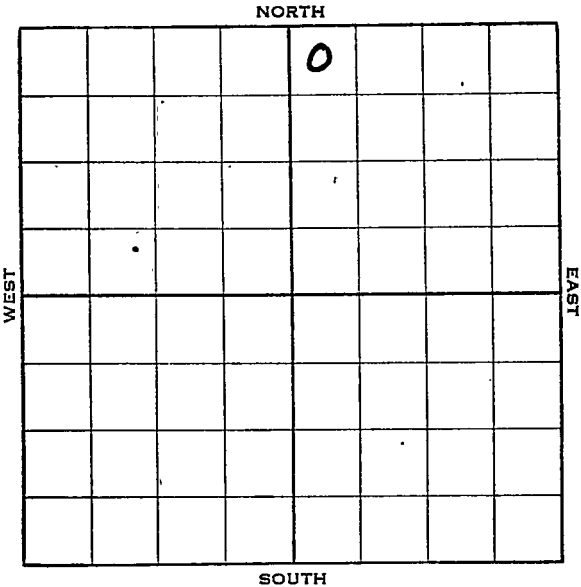

Petty et al Company

330 Ft. from W. Line

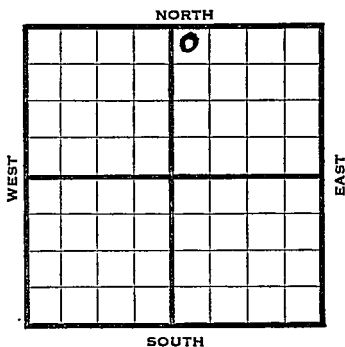[illegible]

Map No. 17 Sec. 31 Twp. 25 R. 14EWell No. 1 TiptonPetty et al

Company

Contractor

FIRST REPORT

NW NE

330 Ft. from N. Line

_____ Ft. from S. Line

_____ Ft. from E. Line

330 Ft. from W. Line

SECTION PLAT

		0	

Location _____

Rig up _____

Drilling and Remarks:

Mach

RECORD

Cased _____ in., _____ ft.

Sand _____

Gas _____

Oil _____

Total Depth _____

PRODUCTION

1st 24 hrs. Nat. _____

1st 24 hrs. after shot _____

Gas _____ Cu. Ft.

Dry Hole _____

Abandoned _____

Date

MAR 23 1938

19

E. D. Hatfield Scout

Woodson KANSAS

Map No. 17 Sec. 31 Twp. 25 R. 14EWell No. 1 TiptonPetty etal Company

Contractor

ABANDONED

NW NE

330 Ft. from N. Line Ft. from S. Line Ft. from E. Line330 Ft. from W. Line

SECTION PLAT

		0	

Location Rig up

Drilling and Remarks:

RECORD

Cased 6 in., 1510 ft.Sand MISS 1502-1775Gas ARB 1857Oil Total Depth 1955

PRODUCTION

1st 24 hrs. Nat. 1st 24 hrs. after shot Gas Cu. Ft.Dry Hole Abandoned

Date

MAY 10 1938

19

H. D. Hatfield

Scout