


KANSAS Barton

Section 28 Township 17 Range 14W

Well No. 6 Meitner "A"

Company Bridgeport

Carroll Pool
NORTH

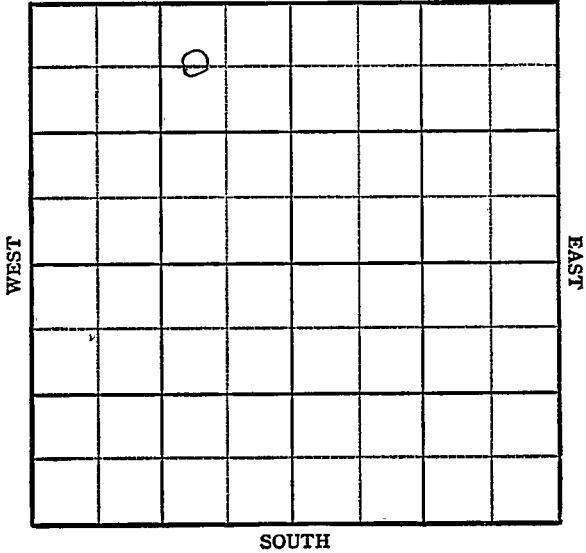

KANSAS

Barton

Sec. 28 Twp. 17 R. 14WWell No. #6 Meitner "A" FarmBridgeport Company

Carroll Pool


660' Ft. from N. Line

Ft. from S. Line

990' Ft. from E. Line

Ft. from W. Line

C W L NE NW

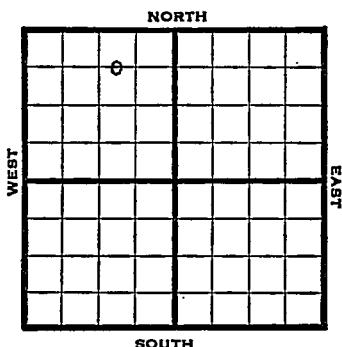

1948

Eli 1858'

REPORT

9/15

Location

9/21

"

9/29

"

10/6

"

10/13

"

10/19

"

10/26

"

11/3

8" @ 854'

Drlg. 1220'

11/10

Lansing 3082'

Arbuckle 3354'

TD 3357'

5" @ 3356'

11/16

TD 3379'

500 acid $1\frac{1}{2}$ bbls fluid PH

60% W "

11/23

"

11/30

"

12/8

Plug 3218'

24 shots 3109-17

Water

Drlg 3457 SWD

Drlg 3650'

12/22

Reagan 3571'

TD 3698'

12/29

TD 3698'

Arb. 3354'

5" @ 3356'

Reagan 3571'

SWD

ABANDONED

Barton County Kansas State

Map No. _____ Sec. 28 Twp. 17 R. 14W

Well No. 6 Meitner "A"

Bridgeport Company

FIRST REPORT

Contractor

C W L NE NW

SECTION PLAT

660 Ft. from N. Line

_____ Ft. from S. Line

990 Ft. from E. Line

_____ Ft. from W. Line

Carroll Pool

Remarks:

Location

Date

SEP 15 1948

Scout

S. J. LEWIS

Map No. 12 Sec. 28 Twp. 17 R. 14W

Well No. 6 Meitner "A"

Bridgeport Company

ABANDONED

Contractor

C W L NE NW

E. 1/1838
SECTION PLAT

660 Ft. from N. Line

 Ft. from S. Line

990 Ft. from E. Line

 Ft. from W. Line

	6		

Barton County

Location

Rig up

Drilling and Remarks:

Cur 3354
5" C 3356
Reagan 3571
BWD

RECORD

Cased in., ft.

Sand

Gas

Oil

Total Depth 3695

PRODUCTION

1st 24 hrs. Nat.

1st 24 hrs. after shot

Gas Cu. Ft.

Dry Hole

Abandoned

Date

DEC 29 1948

S. J. LEWIS

Scout