

Barton


KANSAS

SECTION 27 TOWNSHIP 19 RANGE 14 W

WELL NO. #1 Schumacher

COMPANY Sterling Drilg.

NORTH

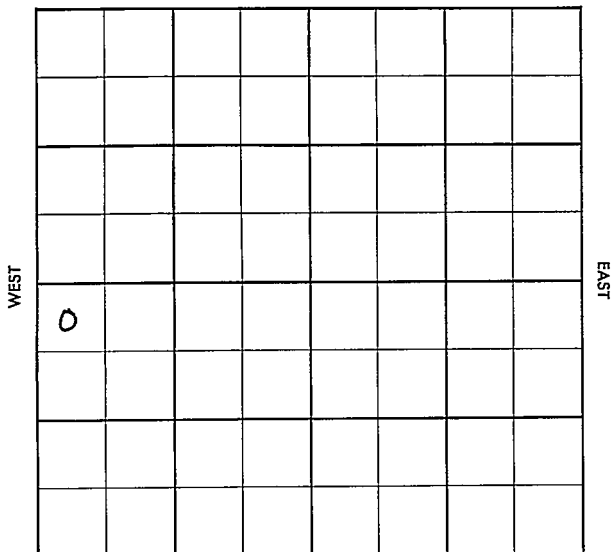


SOUTH

HOT FILE Barton KANSAS

SEC.	TWP.	R.
27	19 S	14 W
WELL NO.		
# 1 Schumacher		
COMPANY		FARM
Sterling Drlg. Co.		
CONTRACTOR		

_____ Ft. from N. Line
 _____ Ft. from S. Line
 _____ Ft. from E. Line
 _____ Ft. from W. Line

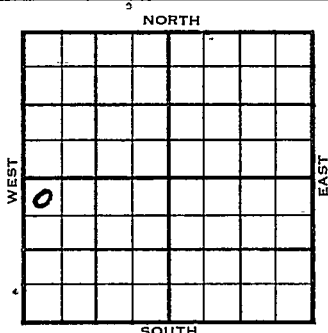

NW NW SW
 SDX DHC \$2,000.00
 (S-24186)

1956	ELEVATION 1888'	KB	1885'	REPORT	(WH5-DC99)
------	--------------------	----	-------	--------	------------

1/16	Arbuckle Test well @ 3500' (See Central File Rm. Corresp.)				
1/18	Location (F.R.Tkt)				
1-26	"				
2-2	"				
###					
2-8	Location				
2-16	"				
2/27	Drlg. 600' (Card-Sterling Drlg.)				
2/28	Drlg. 800' WOC. "				
2/29	Drlg. 1350' "				
3/1	Drlg. 2000' "				
3/3	Drlg. 2745' "				
3/4	Drlg. 3015' "				
3/5	Drlg. 3261' "				
3/6	Drlg. 3345' "				
3/7	Drlg. 3498' "				
3/15	Cherty Cong. 3451', Arb. 3525' TD 3555'. DST 3382-3402, open 1/2 hr, rec 100' OCM, 180' free oil, 740/30" DST 3528-44, open 1 hr rec 10' drlg. mud. 0#. 5 1/2" @ 3450/50 WOC. (Kansas Scout Ltr)				

OVER
 DX-78

1956

3/22

CO PB 3420. 8/3402-04. S/20.69 BO
6 hr. SP 3396. 24/3380-86 2000 A
S/9 BO 1 hr. (Kansas Scout Rpt)

3/23

Schl Laterolog.Survey Copy received.
Given to S.A. Shannon-Div. Geolog.

3/28

Comm. 2-27-56

10" @ 324/200 8-5/8" @ 799

DST 3224-61, open $\frac{1}{2}$ hr. rec 30' mud.

90/20". DST 3382-3402, open $\frac{1}{2}$ hr.

rec 100' OCM, 180' free oil, 740/30"

DST 3528-44, open 1 hr. rec 10' drlg.

mud. O# 5 $\frac{1}{2}$ " @ 3450/50 CO

PB 3420 8/3402-04 S/20.69 BO

6 hrs. SP 3396 24/3380-86. 2000 A

S/9 BO 1 hr. SI 16 hrs. FU 510' oil

100' wtr. S/11 BF CO to 3420

S/8 BF 4 hrs. S/3 $\frac{1}{2}$ BF 2 hrs. 26% wtr.

SI 16 hrs. FU 357' oil, 158' wtr.

S/13.34 BF 6 hrs. 26% wtr.

SI 15 hrs. FU 460' fluid (367' oil

and 93' wtr.) TD 3555' D & A

Tops: Anh 790', H. 3115', BL 3210',

L. 3221', Cherty 3451', A. 3525'

• Log tops: H. 3116', Tr. 3132',

Dg. 3148', BL 3211', L. 3221',

• • BKC 3432', Arb. 3521'

ABANDONED

4/5

Advised Contract Section - D & A

County Barton

Elev. _____

Sec. 27Twp. 19Rge. 14W

Company _____

Sterling Drilling

Farm Name _____

SchunacherNo. 1

TOPS

DEPTH

LOG

DATUM

Loc. in Sec. _____

Anh. _____

Tp. _____

H. _____

Tr. _____

Dg. _____

BL. _____

L. _____

K.C. _____

B.K.C. _____

Ce. _____

C. _____

M. _____

M. _____

K. _____

Mz. _____

Me. _____

V. _____

S. _____

S. _____

A. _____

R. _____

Pe. _____

G. _____

T.D. _____

NW NW SW

Geol. _____

Contr. _____

Pool _____

JAN 13 '56

FIRST REPORT

Date Comm. _____

Sunray Mid-Continent DHM

Location _____

Co.

Lse.

TA No.

Sec.

T.

R.

1888 KB

County Barton Elev. 1885
 Sec. 27 Twp. 19 Rge. 14W
 Company Sterling Drlg.
 Farm Name Schumacher No. 1

TOPS

DEPTH

LOG

DATUM

Loc. in Sec.

NW NW SW

Anh.	790		
Tr.			
H.	3115	3116	
Tr.		3132	
Dg.		3148	
BL.	3210	3211	
L.	3221	3221	1336
K.C.			
B.K.C.		3432	1547
Ce.			
C. <u>Cherty</u>	3451		1566
M.			
M.			
K.			
Mz.			
Mq.			
V.			
S.			
S.			
A	3525	3521	1636
R.			
PE.			
G.			
T.D.	3555		

Geol.

Contr.

Pool

MAR 28 '56

ABANDONED

Date Comm. 2-27-56

10" @ 324/200 8 5/8" @ 799

DST 3221-61 open 1/2 hr. rec. 30' mud

90/20" DST 3382-3402 open 1/2 hr.

rec. 100' ocm 180' free oil 740/30"

DST 3528-44 open 1 hr. rec. 10' drlg.

mud off 5 1/2" @ 3450/50 CO PB 3420

8/ 3402-04 S/ 20.69 bo 6 hr..

SP 3396 . 24/ 3380-86 2000 A

S/ 9 bo 1 hr. SI 16 hr. FU 510' oil
100' wtr. S/ 11 bf CO to 3420

S/ 8 bf 1 hr. S/ 3 $\frac{1}{2}$ bf 2 hr. 26% wtr.
SI 16 hr. FU 357' oil 158' wtr.

S/ 13.34 bf 6 hr. 26% wtr. SI 15 hr.
FU 460' fluid (367' oil 93' wtr.)

D & A

11. 11. 11

APR 4 1956