

O. W. D. D

Section 12 Township 14 Range 15-W

Well No. #3 Boxberger "C"

Company Skelly

NORTH

WEST

EAST

SOUTH

KANSAS

Russell

Sec. 12 Twp. 14 R. 15-W

Well No. #3 Boxberger "C" Farm

Skelly Company


O. I. " D. D

990 Ft. from N. Line

Ft. from S. Line

Ft. from E. Line

710 Ft. from W. Line

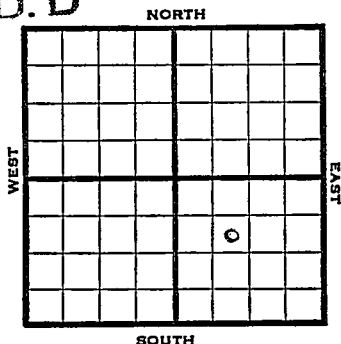

SE NW SE

1945 Elev. 1847' REPORT

12/5 ROR

12/12 Anhy 572
8" @ 888 WOC

12/20 Drlg. 3175'

12/29 Lans. 3011' Arb. 3278'
T.D. 3288' SO. 5" - 3288' RUST.

1946

1/10 " " "

1/17 41 shots 3277-82' No shows.
500 acid.

1/24 " "

1/31 Plug 3026' 70 shots 3010-22'
SSO 750 acid.

2/7 Pump 27 oil & 80 water in 16 hours.
3000 acid. Fsg.

2/14 " " "

2/20 Pump 2 oil in 3 hours.
Shut down.

2/28 " "

3/7 " "

3/13 " "

3/21 " "

3/28 " "

4/3

Lans 3011

Arb. 3278

5" @ 3288

Perf. Lans. 3000 acid.

TD 3288'

Pump 80 oil plus 120 wtr. Pot.

Grav. 39.0

COMPLETED

Kansas Pool Name Big Creek

Map No. K-72 Sec. 12 Twp. 14 R. 15W

Well No. 3 Boxberger "C"

Skelly Company

FIRST REPORT Contractor

SE NW SE

SECTION PLAT

990 Ft. from N. Line

 Ft. from S. Line

 Ft. from E. Line

710 Ft. from W. Line

Russell County

Location

Rig up

Drilling and Remarks:

RUR

RECORD

Cased in., ft.

Sand

Gas

Oil

Total Depth

PRODUCTION

1st 24 hrs. Nat.

1st 24 hrs. after shot

Gas Cu. Ft.

Dry Hole

Abandoned

Date

DEC 5 1945 19

S. J. LEWIS Scout

"**NSAS** Kansas Pool Name Big Creek

Map No. 72 Sec. 12 Twp. 14 R. 15W

Well No. 3 Boxberger "C"

Skelly


Company

COMPLETED

Contractor

SE NW SE

E 11847
SECTION PLAT

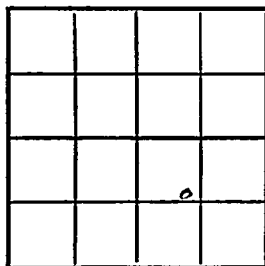

990 Ft. from N. Line

 Ft. from S. Line

 Ft. from E. Line

710 Ft. from W. Line

Russell County

Location

Rig up

Drilling and Remarks:

Leans 3011

CR 3278.

5" CR 255

Prof Leans.

Booocoid

Pump. 80 oil 6 + 120

Water 25

RECORD

Cased in., ft.

Sand

Gas

Oil

Total Depth 3258

PRODUCTION

1st 24 hrs. Nat.

1st 24 hrs. after shot

Gas Cu. Ft.

Dry Hole

Abandoned


Date

390 Gr

APR 3 1946 19

S. J. LEWIS Scout

O. W. D. D

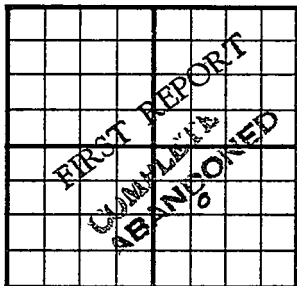County Russell State KansasSec. 12 (Blk. Twp.) 14 (Sur. Rge.) 15W Map No.Operator Skelly OilWell No. 3 Farm Boxberger "C"Elev. Location SE NW SE990 Ft. From N Line SE990 Ft. From W Line Quarter1st. Report DEC 6 1950Completion DEC 6 1950Remarks CHDD

Spudding Date

Drlg. Data - SWD well TD 3425Arb. 3278 OTD 3288 5" @ 3288Regan 3316 Ots. 3407 TD 3425Comp for SWD

J. E. TYRA

1950

12/6

SWD Well

TD3425

Arb. 3278' OTD 3288

5" @ 3288

Reagan 3316' Qts 3407

TD 3425 Comp. for SWD

**FIRST REPORT
ABANDONED**

O.V.D.D