

# KANSAS


FORM 51 5M 10-41 PETROL

Russell

Section 12 Township 14 Range 15-W

Well No. #2 Peterson

Company Braeden & McClure etal

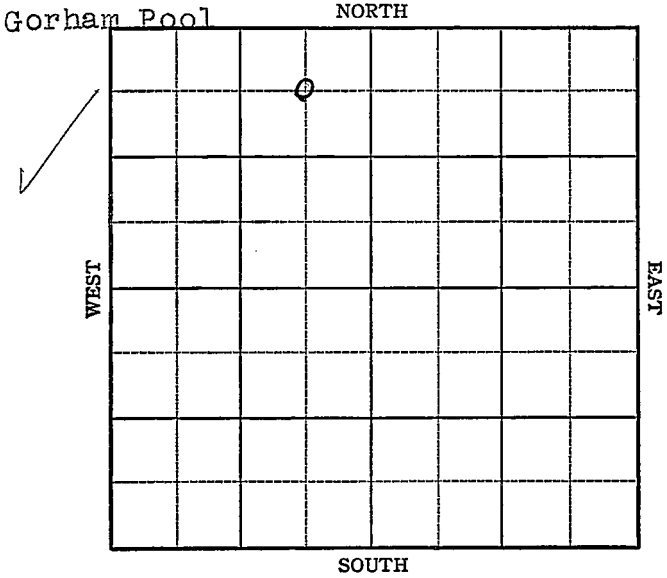

# KANSAS Russell

Form 252-A  
5M 5-42 Petrol

Sec. 12 Twp. 14 R. 15-W

Well No. #2 Peterson Farm

Braden & McClure et al Company

(Gorham Pool)


660 Ft. from N. Line

         Ft. from S. Line

660 Ft. from E. Line

         Ft. from W. Line

Elev. 1866

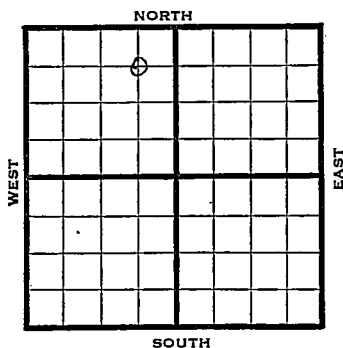

1942

## REPORT

|       |  |
|-------|--|
| 8/12  | Location   |
| 8/19  | "  |
| 8/27  | 8" @ 588 WOC   |
| 9/2   | Drlg. 2558   |
| 9/9   | SD   |
| 9/16  | " "  |
| 9/23  | Arb. 3296' T. D. 3299;<br>SO & W. S.D.   |
| 9/30  | " "  |
| 10/7  | 5" - 3301 T.D. SD.   |
| 10/14 | Moving in tools.   |
| 10/21 | 1000' fluid in 14 hrs SD   |
| 10/28 | "m " " "   |
| 11/4  | Temp pot pump 80 oil   |
| 11/11 | " " "  |
| 11/18 | " " " "  |
| 11/24 | " " " "  |
| 12/2  | " " " "  |
| 12/8  | " " " "  |
| 12/16 | Arb. 3296 Pump 70 bbls. oil plus<br>5" @ 3301' water pot.<br>T.D. 3306' Gravity 36.6 |

**COMPLETED**

Map No. 2 Sec. 12 Twp. 14 R. 15W

Well No. 2 Peterson

Braden & McClure et al Company

**FIRST REPORT** Contractor

SECTION PLAT

C NE NW  
660 Ft. from N. Line

\_\_\_\_\_ Ft. from S. Line

660 Ft. from E. Line

\_\_\_\_\_ Ft. from W. Line

|  |   |  |  |
|--|---|--|--|
|  | o |  |  |
|  |   |  |  |
|  |   |  |  |
|  |   |  |  |

Gorham Pool

Location X

Rig up \_\_\_\_\_

Drilling and Remarks: \_\_\_\_\_

RECORD

Cased \_\_\_\_\_ in., \_\_\_\_\_ ft.

Sand \_\_\_\_\_

Gas \_\_\_\_\_

Oil \_\_\_\_\_

Total Depth \_\_\_\_\_

PRODUCTION

1st 24 hrs. Nat. \_\_\_\_\_

1st 24 hrs. after shot \_\_\_\_\_

Gas \_\_\_\_\_ Cu. Ft.

Dry Hole \_\_\_\_\_

Abandoned \_\_\_\_\_

Date

AUG 12 1942 19

S. J. LEWIS Scout

KANSAS

Russell

Map No. 72 Sec. 12 Twp. 14 R. 15W

Well No. 2 Peterson

Braden & McClure et al. Company

**COMPLETED** Contractor

C NE NW

SECTION PLAT

660 Ft. from N. Line

\_\_\_\_\_ Ft. from S. Line

660 Ft. from E. Line

\_\_\_\_\_ Ft. from W. Line

|  |   |  |  |
|--|---|--|--|
|  | a |  |  |
|  |   |  |  |
|  |   |  |  |
|  |   |  |  |

GORHAM POOL

Location \_\_\_\_\_

Rig up \_\_\_\_\_

Drilling and Remarks:

*Cor 3296*

*5" C 3301*

*Pump 70 oil & water*

*P.O.*

*36 1/2 gal*

RECORD

Cased \_\_\_\_\_ in., \_\_\_\_\_ ft.

Sand \_\_\_\_\_

Gas \_\_\_\_\_

Oil \_\_\_\_\_

Total Depth 3306

PRODUCTION

1st 24 hrs. Nat. \_\_\_\_\_

1st 24 hrs. after shot \_\_\_\_\_

Gas \_\_\_\_\_ Cu. Ft.

Dry Hole \_\_\_\_\_

Abandoned \_\_\_\_\_

Date

DEC 16 1942 19

S. J. LEWIS Scout