FORM 51 5M 6-46 PETROL


KANSAS

Barton county

Section 33 Township 16 Range 11-W

Well No. #8, Bernstoef-Janke

Company Darby

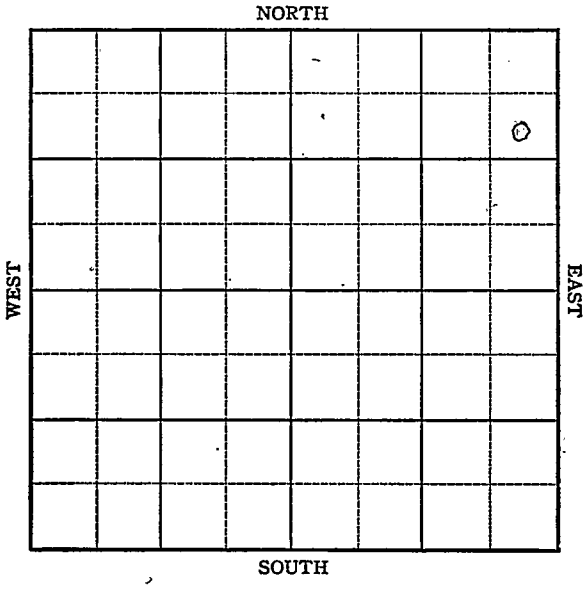

FORM 252-A
5M 6-46 PETROL

KANSAS

Barton ✓

Sec. 33 Twp. 16 R. 11W

Well No. #8 Bernstoef-Janke Farm

Darby Company

Kraft-Prusa


990 Ft. from N. Line

Ft. from S. Line

330 Ft. from E. Line

Ft. from W. Line

SE NE NE

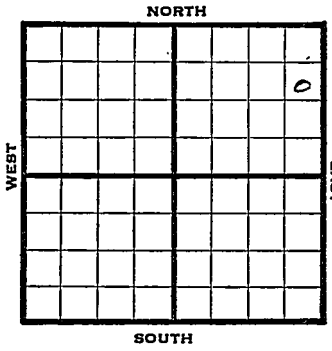

REPORT

1946	Elev. 1922'
10/9	Drilling 210'
10/15	8" @ 440' Drlg 2556'
10/22	Lans 3080' Arb 3355' TD3356 5" @ 3356, RUST
10/29	" "
11/6	TD 3369, 1000 acid Swb 17 oil PH 3 hrs
11/12	" "
11/20	" "
11/27	" "
12/3	" "
12/11	Arb 3355' 5" @ 3356' TD 3369' 1500 Acid Pump 3 91 POT 42.7 Grav

COMPLETED

KANSAS

Form 26 200 Bks 5-42 Petrol Kansas Kraft-Prusa

Map No. 55 Sec. 33 Twp. 16 R. 11W


Well No. 8 Bernstoef-Janke

Darby Company

FIRST REPORT Contractor

SE NE NE

SECTION PLAT

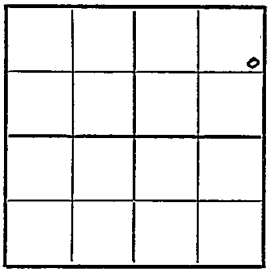

990 Ft. from N. Line

Ft. from S. Line

330 Ft. from E. Line

Ft. from W. Line

Barton County

Location

Rig up

Drilling and Remarks:

210'

RECORD

Cased in., ft.

Sand

Gas

Oil

Total Depth

PRODUCTION

1st 24 hrs. Nat.

1st 24 hrs. after shot

Gas Cu. Ft.

Dry Hole

Abandoned

Date

OCT 9 1946 19 S. J. LEWIS Scout

Form 26 200 Bks. 10-46 Petrol KANSAS Kraft-Prusa
Kansas

Map No. 55 Sec. 33 Twp. 16 R. 11W

Well No. 8 Bernstorf-Janke


Derby Company

COMPLETED Contractor

SE NE NE

El 1922

SECTION PLAT

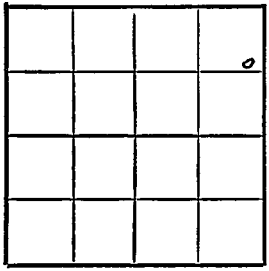

990 Ft. from N. Line

Ft. from S. Line

330 Ft. from E. Line

Ft. from W. Line

Barton County

Location

Rig up

Drilling and Remarks:

Cr 3325
5" @ 3354
100 sacks C
Pump 8 9 10 BX

42 7/8

RECORD

Cased in., ft.

Sand

Gas

Oil

Total Depth: 3369

PRODUCTION

1st 24 hrs. Nat.

1st 24 hrs. after shot

Gas Cu. Ft.

Dry Hole

Abandoned

Date

DEC 1 1 1946 19

S. J. LEWIS Scout