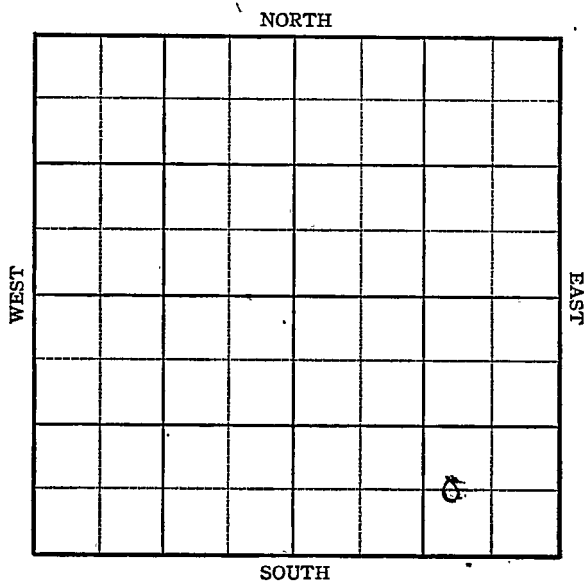


KANSAS Barton

Section 33 Township 16 Range 11-WWell No. #3 RiemanCompany Gulf

KANSAS

Barton County

Sec. 33 Twp. 16 R. 11W

Well No. #3 Rieman Farm


Gulf Company
Kraft-Prusa

 Ft. from N. Line

660 Ft. from S. Line

990 Ft. from E. Line

 Ft. from W. Line

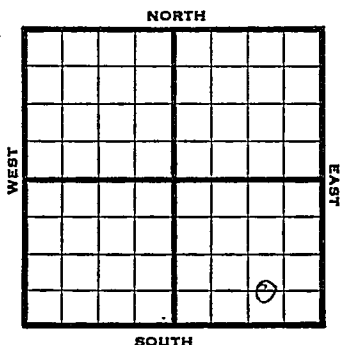

GWL SE SE

1946 Elev. 1899 REPORT

3/6	8" @ 499' WOC
3/14	Drlg. 2895'
3/21	Lans. 3060' Arb. 3327'
	5" - 3328' T.D. 3336'
	2600' oil 5 hours.
3/28	T.D. 3343' 2000 acid.
	Pump 197 oil in 8 hours.
4/4	" " "
4/10	" " "
4/16	" " "
4/21	Arb. 3327
	5" @ 3328
	2000 acid.
	TD 3343
	Pump 387 Pot.
	Grav. 42.0

COMPLETED

KANSAS ~~Kansas~~ Pool Name Kraft-PrusaMap No. 53 Sec. 33 Twp. 16 R. 11WWell No. 3 RiemanGulf Company

FIRST REPORT

Contractor

C W L SE SE

SECTION PLAT

			D

Ft. from N. Line660 Ft. from S. Line990 Ft. from E. LineFt. from W. LineBarton County

Location _____

Rig up _____

Drilling and Remarks:
8"-499 WOC

RECORD

Cased _____ in., _____ ft.

Sand _____

Gas _____

Oil _____

Total Depth _____

PRODUCTION

1st 24 hrs. Nat. _____

1st 24 hrs. after shot _____

Gas _____ Cu. Ft.

Dry Hole _____

Abandoned _____

Date

MAR 6 1946 19S. J. LEWIS Scout

KANSASKansas Pool Name Kraft-PrusaMap No. 55 Sec. 33 Twp. 16 R. 11WWell No. 3 RiemanGulf

Company

COMPLETED

Contractor

C W L SE SE

E 1/1899
SECTION PLAT

			0

 Ft. from N. Line660 Ft. from S. Line990 Ft. from E. Line Ft. from W. LineBarton CountyLocation Rig up

Drilling and Remarks:

Core 3327
5' @ 3328
2000 Acid
Pump 3870 ft

42 2/3**RECORD**Cased in., ft.Sand Gas Oil Total Depth 32340**PRODUCTION**1st 24 hrs. Nat. 1st 24 hrs. after shot Gas Cu. Ft.Dry Hole Abandoned

Date

APR 24 194619S. J. LEWIS

Scout