
FORM 51

Barton KANSAS

Section 26 Township 19 Range 14 W

Well No. # 6 Russell "A"

Company Helmerich & Payne

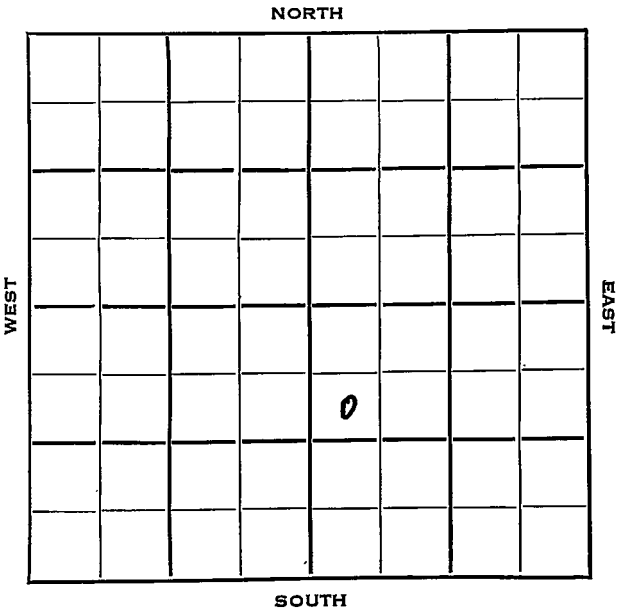

FORM 252-B

Barton KANSAS

Sec. 26 Twp. 19 R. 14W

Well No. #6 Russell "A" Farm

Helmerich & Payne Company

Peel Bros. Contractor

Gt. Bend Airport Pool


990 Ft. from N. Line

Ft. from S. Line

Ft. from E. Line

330 Ft. from W. Line

SW NW SE

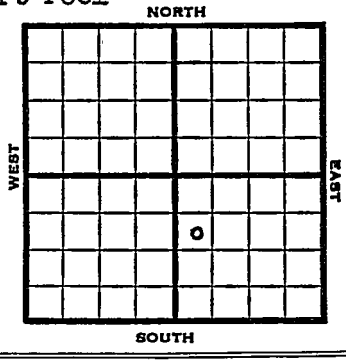

1953	Elev. 1872' REPORT
7/22	Cellar & Pits
7/29	Anhy 792 8" @ 797 Drlg. 2020
8/5	Heeb 3088 Tor 3106 Br li 3182 Lans 3197 DST 3281-3300, 1/2 hr, 5' M 0# DST 3315-28, 1 hr, 35" M Cong 3439 Arb. 3476 RTD 3482 Schl 5" @ 3477
8/12	DD 3491'
8/19	NR
9/2	Spud 7-22-53 Oil Well TD 3503 Anhy 792 8" @ 797 Heeb 8088, Tor 3106, Br lime 3182, Lans 3197, DST 3281-3300, opn ½ hrs., rec. 5' mud, 0# DST 3315-28, opn 1 hr., rec. 35' socm, 0# Cong 3439, Arb. 3476

OVER

(Information Brought Forward)

1953
9/2 TD 3482
5" @ 3477
DD 3491, S/3 goph 2000A, DD 3491
S/3 goph 2000A, DD 3503 wtr.
PB 3396, 24/3358-64, S/½ gwph, 500A
S/6 bw ½ boph PB 3352
48/3338-46, S/4 bwph PB 3332,
48/3320-26, 500A, S/½ boph
3000A, S/20 boph SP 3240,
~~XX~~ 36/3200-06, 500A, S/10 goph
3000A, S/10 bopd CO to 3332
Comp. 43 bopd 23%

COMPLETED

FORM 275 FOR SALE BY KANSAS BLUE PRINT CO.


County Barton State Kansas

Sec. 26 (Blk. Twp.) 19 (Sur. Rge.) 14W Map No.

Operator Helmerich & Payne

Well No. 6 Farm Russell "A"

Elev. Location SW NW SE

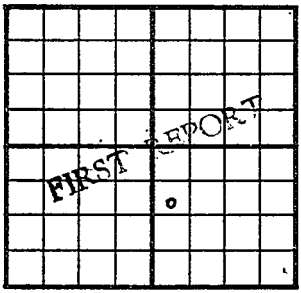

990 Ft. From N Line SE

330 Ft. From W Line Quarter

1st. Report JUL 22 1953

Completion

Remarks

Peel Bros. - Contr.

Spudding Date

Drlg. Data Gt. Bend Airport Pool

Cellar & pits

J. G. McGEHEE

FORM 275 FOR SALE BY KANSAS BLUE PRINT CO.


County Barton State Kansas

Sec. 26 (Blk. Twp.) 19 (Sur. Rge.) 14W Map No.

Operator Helmerich & Payne

Well No. 6 Farm Russell "A"

Elev. 1872 Location SW NW SE

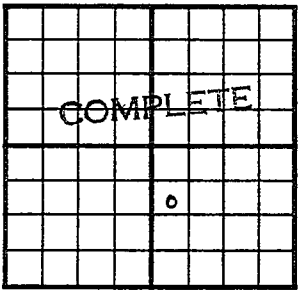

990 Ft. From N Line SE

330 Ft. From W Line Quarter

1st. Report

Completion SEP 2 1953

Remarks Gt. Bend Airport Pool
Peel Bros. - Contr.

Spudding Date 7-22-53

Drlg. Data Oil well TD 3503

Anhy 792 8" @ 797 Heeb. 3088

Tor. 3106 Br. lime 3182 Lans. 3197

DST 3281-3300 open ½ hr. Rec. 5' mud

0# DST 3315-28 open 1 hr. Rec.35'

socm 0# Cong. 3439 Arb. 3476

TD 3482 5" @ 3477 DD 3491

S/ 3 goph 2000 A DD 3503 wtr.

PB 3396 24/ 3358-64 S/ ½ gwph 500 A

S/ 6 bw ½ boph PB 3352 48/ 3338-46

S/ 4 bwph PB 3332 48/ 3320-26 500 A

S/ ½ boph -3000 A S/ 20 boph SP 3240

36/ 3200-06 500 A S/ 10 goph 3000 A

S/ 10 bopd CO to 3332 Comp. 43 bopd 23%

J. G. McGEHEE