


Barton KANSAS

Section 34 Township 16 Range 11 WWell No. #1 FreesCompany Murfin & Aledo

NORTH

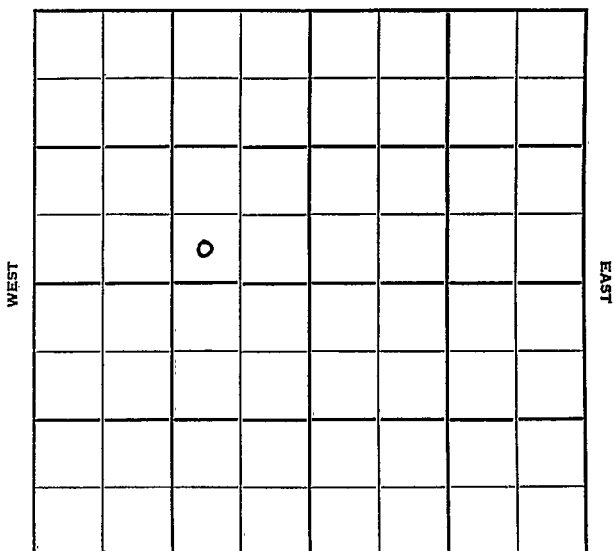

SOUTH

Barton

KANSAS

Sec. 34 Twp. 16 R. 11W

Well No. #1 Frees Farm

Murfin & Aledo Company

Murfin Drl g.- Contr. Contractor
Kraft-Prusa Pool


Ft. from N. Line

330' Ft. from S. Line

990' Ft. from E. Line

Ft. from W. Line

SW SE NW

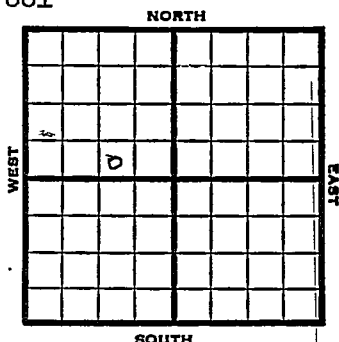

1951 Elev. 1924' REPORT

1/31 Spud 1-25-51
8" @ 824'
Anhy 755-75
3/21 Drlg. 1890'
Spud 1-25-51
Oil Well TD 3389
8"@ 224
Anhy 755-75
Top. 2716'
Heeb. 2971 Dodge 2989
Br Lime 3074 Lans. 3094
Gong. 3358' Arb. 3370
DST 3371-79 opn 15 min
Rec. 2585' oil
TD 3389
5" @ 3371 FU 2850 oil in 15 min
Comp. Echo pot. 2399 bo 14% wtr.

COMPLETED

J. E. TYRA

~~J. E. TYRA~~