


KANSAS Barton

Section 34 Township 16 Range 11WWell No. 1 FreesCompany Aledo Oil & Gas

Kraft-Prusa Pool

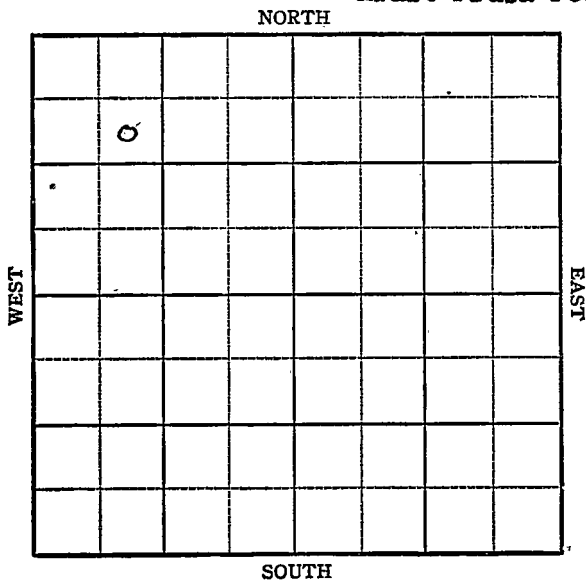

KANSAS Barton

Sec. 34 Twp. 16 R. 11-W ✓

Well No. #1 Frees Farm

Aledo Oil & Gas

Company

Kraft-Prusa Pool


990 Ft. from N. Line

 Ft. from S. Line

 Ft. from E. Line

990 Ft. from W. Line

SE NW NW

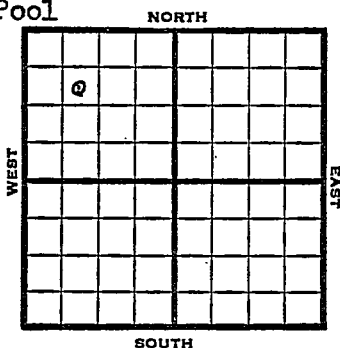

1948

Elev. 1932' REPORT

10/6

8" @ 362'

Anhy 760'

D₁lg 2635'

10/13

Lens. 3099'

Arb. 3416'

TD 3425'

ABANDONED

Map No. _____ Sec. 34 Twp. 16 R. 11W

Well No. 1 Frees

Aledo Oil & Gas Company

FIRST REPORT Contractor

SE NW NW


SECTION PLAT

990 Ft. from N. Line

_____ Ft. from S. Line

_____ Ft. from E. Line

990 Ft. from W. Line

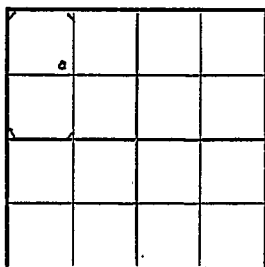

Barton County

Location _____

Rig up _____

Drilling and Remarks:

8" @ 362

Anhy 760

drlg. 2635

RECORD

Cased _____ in., _____ ft.

Sand _____

Gas _____

Oil _____

Total Depth _____

PRODUCTION

1st 24 hrs. Nat. _____

1st 24 hrs. after shot _____

Gas _____ Cu. Ft.

Dry Hole _____

Abandoned _____

Date

OCT 6 1948 19

S. J. LEWIS Scout

Map No. 55 ^{Kansas} Sec. 34 Twp. 16 R. 11W

Well No. 1 Frees

Aledo Oil & Gas

Company

ABANDONED

Contractor

SE NW NW


E 1, 1932
SECTION PLAT

990 Ft. from N. Line

_____ Ft. from S. Line

_____ Ft. from E. Line

990 Ft. from W. Line

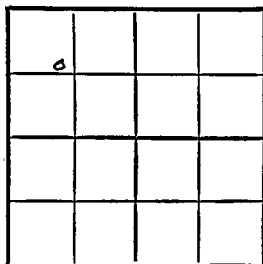

Barton County

Location _____

Rig up _____

Drilling and Remarks:

Lease 3099

Ac 3416

RECORD

Cased _____ in. _____ ft.

Sand _____

Gas _____

Oil _____

Total Depth 3425

PRODUCTION

1st 24 hrs. Nat. _____

1st 24 hrs. after shot _____

Gas _____ Cu. Ft.

Dry Hole _____

Abandoned _____

Date

OCT 13 1948

19

S. J. LEWIS

Scout