


Section 11 Township 14 Range 15-W

Well Number 3 Dumbler "B"

Company Darby Pet.

NORTH

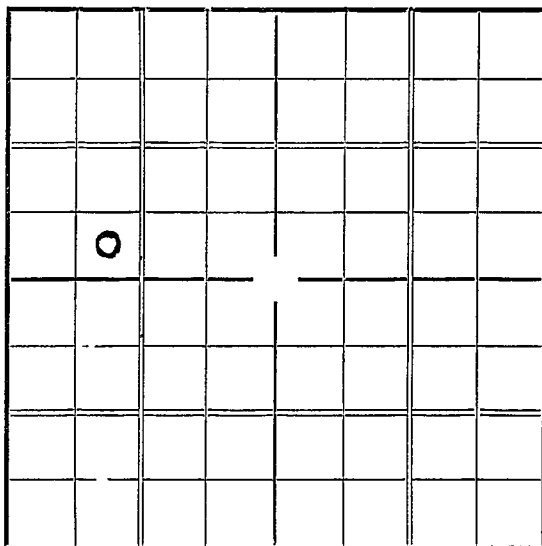

WEST

EAST

SOUTH

KANSAS *Russell*Map No. _____ Sec. 11 Twp. 14 R. 15WWell No. 3 Dumbler "B"Harby Pet Company

Contractor

SECTION PLAT

_____ Ft. from N. Line

330 Ft. from S. Line

_____ Ft. from E. Line

990 Ft. from W. Line

FIRST REPORT

Location ✓

Rig up _____

Drilling and Remarks:

RECORD

Cased _____ in., _____ ft.

Sand _____

Gas _____

Oil _____

Total Depth _____

PRODUCTION

1st 24 hrs. Nat. _____

1st 24 hrs. after shot _____

Gas _____ Cu. Ft.

Dry Hole _____

Abandoned _____

Date

APR 14 1937

S. J. LEWIS

Scout

Russell KANSAS

Map No. 72 Sec. 11 Twp. 14 R. 15^w

Well No. 3 - Dumbler "B"

Darby Pet. Company
Contractor

COMPLETED

SECTION PLAT

_____ Ft. from N. Line

530 Ft. from S. Line

_____ Ft. from E. Line

990 Ft. from W. Line

Location _____

Rig up _____

Drilling and Remarks:

Pat 1091

RECORD

Cased 7 in., 3268 ft.

Sand Sil 3272

Basal Sand 5278

Gas _____

Oil _____
Total Depth 3282

PRODUCTION

1st 24 hrs. Nat. _____

1st 24 hrs. after shot _____

Gas _____ Cu. Ft.

Dry Hole _____

Abandoned _____

Date

JUN 2 1937

H. D. Hatfield Scout