


Form 51-5M-2-29-34703
 Map No. KANSAS Sec. 33 Twp. 20 R. 3rd
 Well No. J. Mc Gurdy Farm
Sen Clair Oil Company

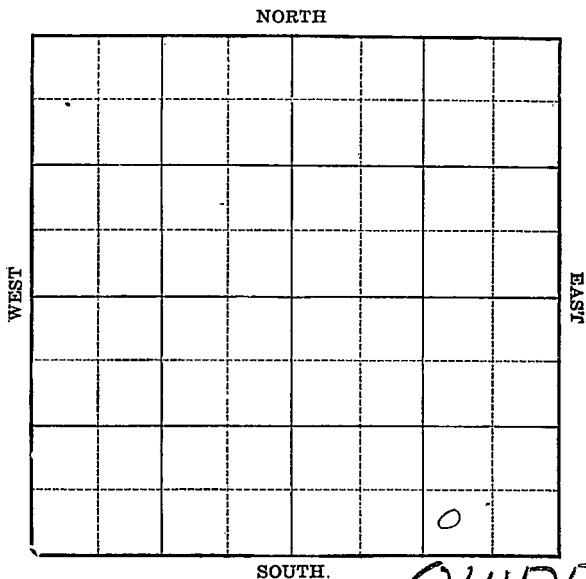

OWDD

Location _____

Drilling Remarks _____

Rig Up _____

Drilling Remarks _____

RECORD

Cased _____ in. _____ ft.

Sand _____

Gas _____

Oil _____

Total Depth _____

PRODUCTION

1st 24 hrs. Nat. _____

1st 24 hrs. after shot _____

Gas _____ cu. ft. _____

Dry Hole _____


Abandoned _____

McPherson

Map No. KANSAS Sec. 33 Twp. 20 R. 3^w

Well No. 2- McCurdy Farm
Imclair Oil & Gas Company

_____ Ft. from N. Line
330 Ft. from S. Line
940 Ft. from E. Line
_____ Ft. from W. Line
1930

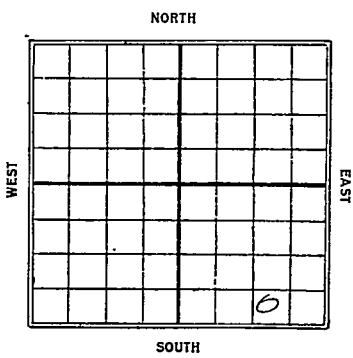

| Date | REPORT |
|------|----------------------|
| 5/21 | Loc |
| 5/28 | Rig |
| 6/4 | Spud 143' |
| 6/11 | Wdg. 1875' |
| 6/18 | " 2370' |
| 6/25 | Top Shat 2940' |
| | Crust 3213' |
| 7/2 | 5" 3224' |
| 7/9 | Viola 3235' |
| | 2000' oil Wdg. 3274' |
| 7/16 | Melcor 3277-3313 |
| | TD 3313 |
| | Swab 600 bbl oil |
| | Comp. |
| 1931 | OWDD ✓ |
| 6/17 | Old T.D. 3310' |
| | Top Chlc line 3328 |
| | Swab 450 bbl 24 hr |
| | Wdg 3329' |
| 6/24 | T.D. 3329' Testing |
| | (over) |

7/1 Top Selic line 3328
TD 3331
Swab 1200 lbe oil
Comp

Map No. **KANSAS** Sec. 33 Twp. 20 R. 3 W

Well No. 43 2 Mc Murdo

Sincclair Oil & Gas Company

Contractor

SECTION PLAT

..... Ft. from N. Line

330 Ft. from S. Line

990 Ft. from E. Line

..... Ft. from W. Line

| | | | |
|--|--|--|---|
| | | | |
| | | | |
| | | | |
| | | | |
| | | | 0 |

FIRST REPORTS

Location

Rig up

Drilling and Remarks:

RECORD

Cased..... in., ft.

Sand

Gas

Oil

Total Depth.....

PRODUCTION

1st 24 hrs. Nat.....

1st 24 hrs. after shot.....

Gas..... Cu. Ft.

Dry Hole.....

Abandoned.....

Date

MAY 21 1930

S. J. LEWIS Scout

Map No. **KANSAS** Sec. 33 Twp. 20 R. 3W

Well No. 2. N^o Purdoly

Sinclair Oil & Gas Company

Contractor

SECTION PLAT

| | | | |
|--|--|--|---|
| | | | |
| | | | |
| | | | |
| | | | o |

_____ Ft. from N. Line

330 Ft. from S. Line

990 Ft. from E. Line

_____ Ft. from W. Line

COMPLETED

RECORD

Location _____

Cased _____ in., _____ ft.

Rig up _____

Sand _____

Drilling and Remarks:

Gas _____

Wells 8277-

Oil _____

3313

Total Depth 3219

PRODUCTION

small 600 gals.

1st 24 hrs. Nat. _____

1st 24 hrs. after shot _____

Gas _____ Cu. Ft.

Dry Hole _____

Abandoned _____

Date

JUL 16 1930

S. J. LEWIS

Scout

43 KANSAS

McPherson

Map No. Sec. 33 Twp. 20 R. 3^W

Well No. 2 McCurdy

Sinclair Oil & Gas Company

Contractor

FIRST REPORTS

SECTION PLAT

Ft. from N. Line

330 Ft. from S. Line

990 Ft. from E. Line

Ft. from W. Line

"O W O O"

| | | | |
|--|--|--|--|
| | | | |
| | | | |
| | | | |
| | | | |
| | | | |

Location

Old TD 3310'

Drilling and Remarks:

Top bit 3328'
Dwabs 450 lbs
24 hours.
Drg 3329'

RECORD

Cased.....in.,ft.
Sand.....
Gas.....
Oil.....
Total Depth.....

PRODUCTION

1st 24 hrs. Nat.....
1st 24 hrs. after shot.....
Gas.....Cu. Ft.
Dry Hole.....
Abandoned.....

Date

JUN 17 1931

CHAS. L. SHERWOOD
Scout

43 *McPherson*
 Map No. **KANSAS** Sec. **33** Twp. **20** R. **3** ^W

Well No. **2** *McCurdy*
Sinclair Oil & Gas Co. Company

Contractor

COMPLETE**SECTION PLAT**

.....Ft. from N. Line

330 Ft. from S. Line**990** Ft. from E. Line

.....Ft. from W. Line

| | | | |
|--|--|--|---|
| | | | |
| | | | |
| | | | |
| | | | 0 |

Location.....

Rig up.....

Drilling and Remarks:

*Top Sili 3328'**Shoal 1700 Bl.***RECORD**

Cased.....in.,ft.

Sand.....

Gas.....

Oil.....

Total Depth.....**3331****PRODUCTION**

1st 24 hrs. Nat.....

1st 24 hrs. after shot.....

Gas.....Cu. Ft.

Dry Hole.....

Abandoned.....

Date

JUL 1 1931**CHAS. L. SHERWOOD**

192.....

Scout