


Section 10 Township 28 Range 7-E

Well No. #4 Sawyer "A"

Company Adair & Morton

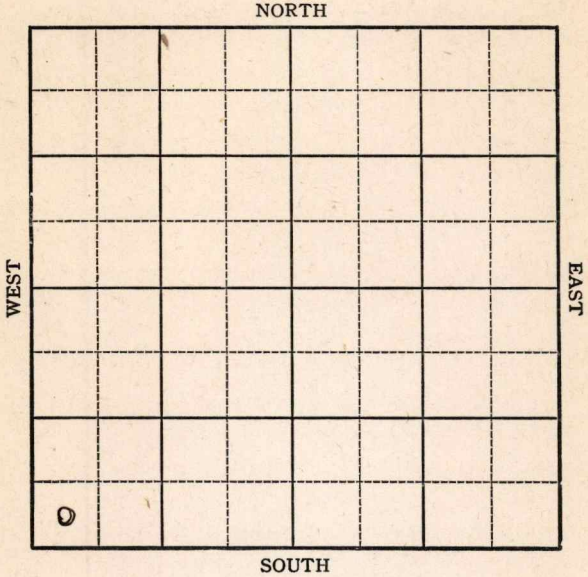

Sec. 10 Twp. 28 R. 7-E

Well No. #4 Sawyer "A" Farm


Adair & Morton Company

_____ Ft. from N. Line

330 Ft. from S. Line

_____ Ft. from E. Line

330 Ft. from W. Line

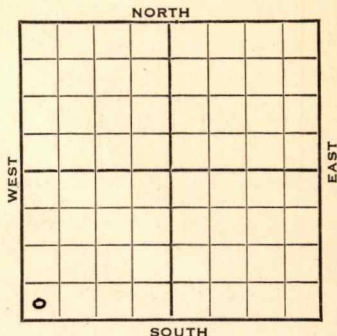

1943

REPORT

8/25	Machine
9/1	"
9/8	12" @ 810 Drlg. 856'
9/15	10" @ 1440 1485' UR
9/22	10" @ 1510 Lans 1675 KC 1995 Drlg. 2090'
9/29	Miss 2712 T.D. 2742'

ABANDONED

KANSAS

Map No. 10 Sec. 10 Twp. 28- R. 7E

Well No. 4 Sawyer "A"

Adair & Morton

Company

FIRST REPORT

Contractor

SW/C

_____ Ft. from N. Line

330 Ft. from S. Line

_____ Ft. from E. Line

330 Ft. from W. Line

SECTION PLAT

6

Miscellaneous

Location _____

Rig up _____

Drilling and Remarks:

Machine

RECORD

Cased _____ in., _____ ft.

Sand _____

Gas _____

Oil _____

Total Depth _____

PRODUCTION

1st 24 hrs. Nat. _____

1st 24 hrs. after shot _____

Gas _____ Cu. Ft.

Dry Hole _____

Abandoned _____

Date

AUG 25 1943 19

S. J. LEWIS Scout

KANSAS

Map No. 10 Sec. 10 Twp. 28 R. 7E

Well No. 4 Sawyer "A"

Adeir & Morton Company

ABANDONED Contractor

SW/C

SECTION PLAT

_____ Ft. from N. Line

330 Ft. from S. Line

_____ Ft. from E. Line

330 Ft. from W. Line

Miscellaneous

Location _____

Rig up _____

Drilling and Remarks:

Miss 2712

RECORD

Cased _____ in., _____ ft.

Sand _____

Gas _____

Oil _____

Total Depth 2742

PRODUCTION

1st 24 hrs. Nat. _____

1st 24 hrs. after shot _____

Gas _____ Cu. Ft.

Dry Hole _____

Abandoned _____

Date

SEP 29 1943

19

S. J. LEWIS

Scout