


Section 10 Township 28 Range 7E

#5

Well No. #1 Sawyer "A"

Company Adair & Morton

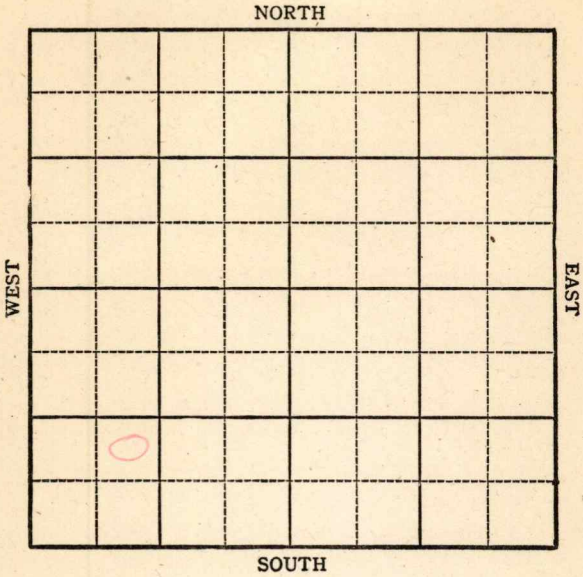

Sec. 10 Twp. 28 R. 7E

Well No. ~~#1~~ #5 Sawyer "A" Farm

Adair & Morton Company


Miscellaneous

_____ Ft. from N. Line

990 Ft. from S. Line

_____ Ft. from E. Line

990 Ft. from W. Line

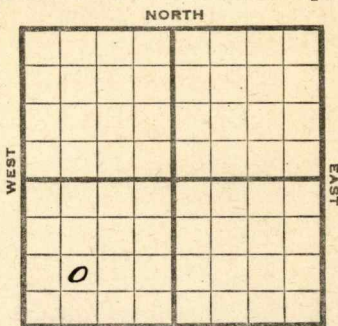

NE SW SW

Elev. 1469

SOUTH

1944

R E P O R T

- 10/18 Spud
- 10/25 Drlg. 650
- 11/1 12" @ 865
- 10" @ 1540
- Drlg. 1547
- 11/8 **KC 2010**
- 8" @ 2184
- Drlg.
- 11/16 **Miss 2737**
- 5" @ 2742
- TD 2762
- 500' oil 12 hrs.
- 11/22 **Miss. 2737**
- 5" @ 2742
- 3000 acid
- TD 2762
- Pump 250 Pot.
- Grav. 38.3

COMPLETED

Pool Name Miscellaneous**KANSAS**Map No. 10 Sec. 10 Twp. 28 R. 7EWell No. 1 Sawyer "A"Adair & Morton CompanyFIRST REPORT ContractorNE SW SW

SECTION PLAT

_____ Ft. from N. Line

990 Ft. from S. Line

_____ Ft. from E. Line

990 Ft. from W. LineButler County

RECORD

Location _____

Cased _____ in., _____ ft.

Rig up _____

Sand _____

Drilling and Remarks: _____

Gas _____

Spud _____

Oil _____

Total Depth _____

PRODUCTION

1st 24 hrs. Nat. _____

1st 24 hrs. after shot _____

Gas _____ Cu. Ft.

Dry Hole _____

Abandoned _____

Date

OCT 1 8 194419S. J. LEWISScout

Pool Name Miscellaneous

Map No. 10 Sec. 10 Twp. 28 R. 7E

Well No. 5 Sawyer "A"

Adair & Morton Company

COMPLETED

Contractor

NE SW SW

SECTION PLAT

_____ Ft. from N. Line

990 Ft. from S. Line

_____ Ft. from E. Line

990 Ft. from W. Line

o			

Butler

Location _____

Rig up _____

Drilling and Remarks:

Miss 2787
5' 02742
3000 acid
Pump 250 ft.
353 ft

RECORD

Cased _____ in., _____ ft.

Sand _____

Gas _____

Oil _____

Total Depth 2762

PRODUCTION

1st 24 hrs. Nat. _____

1st 24 hrs. after shot _____

Gas _____ Cu. Ft.

Dry Hole _____

Abandoned _____

Date

NOV 22 1944 19

S. J. LEWIS Scout