FORM 252-B
10M 10-50 PETROL

Barton

KANSAS

Sec. 30 Twp. 19 R. 12W

Well No. #2 Kohler Farm

W. L. Hartman Company

B & B Drlg. Contractor

Ft. Zarah


Ft. from N. Line

330 Ft. from S. Line

Ft. from E. Line

990 Ft. from W. Line

SE SW SE

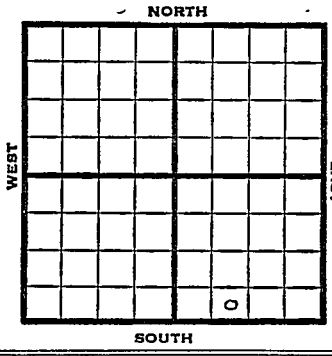

1951	Elev. 1827' **REPORT**
11/14	Spud 11-9-51 8" @ 134' Anhy 625 Drlg. 1970'
1952 2/6	TD 3410 5" @ 3405
2/13	No report
2/20	"
2/27	Spud 11-9-51 Oil Well TD 3410 8" @ 134' Anhy 625 Top. 2738 DST 2786-98 open 1 hr. DST 2920-28 Heeb. 2971 DST 2940-61 open ½ hr. Rec. 10' mud DST 2990-3010 open 5 min. rec. 35' gco Br Li 3088 Lans. 3100 DST 3104-20 open 8 min. rec. 90' GCM DST 3118-33 open 10 min. rec. 150' ho & gcm DST 3134-47 open 9 min. rec. 310' oil DST 3146-58 open 30 min. rec. 30' gcm DST 3157-77 open 1 hr. rec. 20' mud TD 3407 5" @ 3405 DST 3176-93 open 10 min. rec. 125' gocm DST 3194-3210 open 1 hr. rec. 155' muddy wtr.

OVER

1952

2/27 DST 3244-60 open 1 4 min.
rec. 250' mco
DST 3264-78 open 3 min. rec. 2100'
gas 50' so & mcw
DST 3318-32 open ½ hr. rec. 130'
hO & gcm
Cong. 3350 Arb. 3387-90
5" @ 3388 TD 3410
500 A Comp. 363 bopd

COMPLETED

FORM 275 FOR SALE BY KANSAS BLUE PRINT CO.


County Barton State Kansas

Sec. 30 (Blk. Twp.) 19 (Sur. Rge.) 12W Map No.

Operator W. L. Hartman

Well No. 2 Farm Kohler

Elev. Location SE SW SE

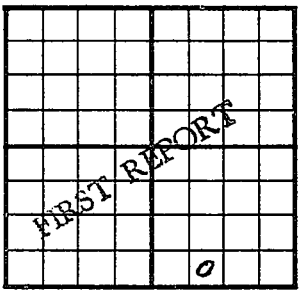

330 Ft. From S Line SE

990 Ft. From W Line Quarter

Ist. Report NOV 14 1951

Completion

Remarks

B & B Drlg. - Contr.

Spudding Date 11-9-51

Drlg. Data Ft. Zarah

8" @ 134 Arbuy 625 Drlg. 1970

J. E. TYRA

FORM 275 FOR SALE BY KANSAS BLUE PRINT CO.


County Barton State Kansas

Sec. 30 (Blk. Twp.) 19 (Sur. Rge.) 12W Map No.

Operator W. L. Hartman

Well No. 2 Farm Kohler

Elev. 1827 Location SE SW SE

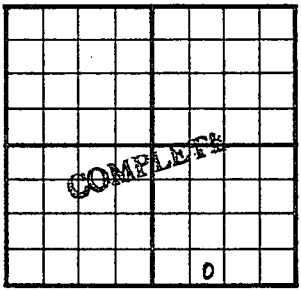

330 Ft. From S Line SE

990 Ft. From W Line Quarter

1st. Report

Completion FEB 2 7 1952

Remarks Ft. Zarah Pool

B & B Drlg. - Contr.

Spudding Date 11-9-51

Drlg. Data Oil well TD 3410

8" @ 134 Anhy 625 Top. 2738

DST 2786-98 open 1 hr. DST 2920-28

Heeb. 2971 DST 2940-61 open ½ hr.

Rec. 10' mud DST 2990-3010 open 5 min.

Rec. 35' gcm Br. lime 3088 Lans. 3100

DST 3104-20 open 8 min. Rec. 90' gcm

DST 3118-33 open 10 min. Rec. 150' ho

& gcm DST 3134-47 open 9 min.

Rec. 310' oil DST 3146-58 open 30 min.

Rec. 30' gcm DST 3157-77 open 1 hr.

Rec. 20' mud TD 3407 5" @ 3405

DST 3176-93 open 10 min. Rec. 125' gocm

DST 3194-3210 open 1 hr. Rec. 155'

muddy water DST 3244-60 open 14 min.

J. G. McGEHEE

Drlg. Data


Rec. 250' mco DST 3264-78 open 3 min.

Rec. 2100' gas 50' so & mcw DST 3318-32

open ½ hr. Rec. 130' ho & gcm Cong. 3350

Arb. 3387-90 5" @ 3388 TD 3410 500 A

Comp. 363 bopd

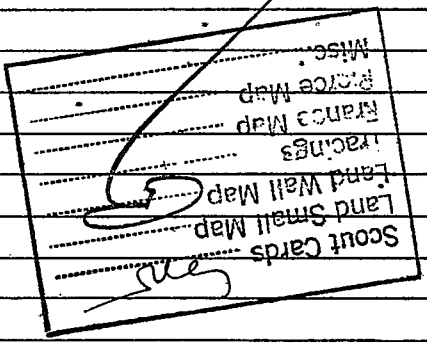

MAR 3 1952