

Section 10 Township 28 Range 7-E

Well No. #2 Thomas

Company Adair & Morton

NORTH

Brandt Pool

WEST

EAST

						0	

SOUTH

KANSAS

Butler

Sec. 10 Twp. 28 R. 7-EWell No. #2 Thomas FarmAdair & Morton Company


(Brandt)

_____ Ft. from N. Line

330 Ft. from S. Line990 Ft. from E. Line

_____ Ft. from W. Line

Elev. 1466

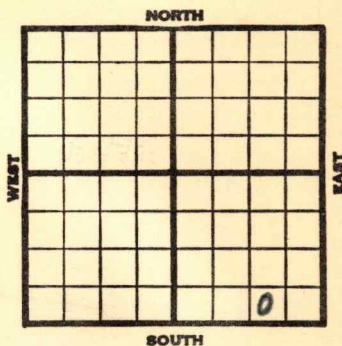

REPORT

1940

3/13

Machine.

3/21

Drlg. 500'

3/28

12" - 860'

Fsg. 1300'

4/4

10" - 1530' K.C. 2000'

Drlg. 2050'

4/12

Miss. 2737-47' T.D.

SSO 2739' 5" - 2739' WOC.

4/17

Miss. 2737'

5" - 2739'

T.D. 2759'

3000 acid.

Pump 45 bbls.

COMPLETED

Map No. 10 Sec. 10 Twp. 28 R. 7EWell No. 2 ThomasAdair & Morton

Company

Contractor

COMPLETED

SW SE SE

 Ft. from N. Line330 Ft. from S. Line990 Ft. from E. Line Ft. from W. Line

BRANDT POOL

SECTION PLAT

			◊

Location Rig up

Drilling and Remarks:

*Miss 2737**5°C 2789**3000 acid**Pump 458 ft*

RECORD

Cased in., ft.Sand Gas Oil Total Depth 2759

PRODUCTION

1st 24 hrs. Nat. 1st 24 hrs. after shot Gas Cu. Ft.Dry Hole Abandoned

Date

APR 17 1940

19

S. J. LEWIS

Scout

Map No. 10 Sec. 10 Twp. 28 R. 7EWell No. 2 ThomasAdair & Morton

Company

Contractor

FIRST REPORT

SW SE SE

Ft. from N. Line

330 Ft. from S. Line990 Ft. from E. Line

Ft. from W. Line

SECTION PLAT

			0

BRANDT POOL

Location _____

Rig up _____

Drilling and Remarks:

Machine

RECORD

Cased _____ in., _____ ft.

Sand _____

Gas _____

Oil _____

Total Depth _____

PRODUCTION

1st 24 hrs. Nat. _____

1st 24 hrs. after shot _____

Gas _____ Cu. Ft.

Dry Hole _____

Abandoned _____

Date

MAR 13 1940 19

S. J. LEWIS Scout