

DX 78-1 Barton

KANSAS

Section 26 Township 19 Range 13W

Well No. #1 Nicholson

Company J. A. Terteling & Sons & CRA 3

NORTH

|  |  |   |  |  |  |  |  |
|--|--|---|--|--|--|--|--|
|  |  |   |  |  |  |  |  |
|  |  | 0 |  |  |  |  |  |
|  |  |   |  |  |  |  |  |
|  |  |   |  |  |  |  |  |
WEST

EAST

SOUTH

Barton

KANSAS

SEC.

TWP.

R.

26

-19

13W

WELL NO.

#1 Nicholson

FARM

COMPANY

J.A. Terteling &amp; Sons &amp; CRA

CONTRACTOR

Harms-Burt

Red Brick


FT. FROM N. LINE

FT. FROM S. LINE

FT. FROM E. LINE

FT. FROM W. LINE

SW NE NW

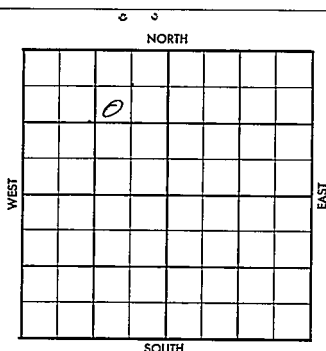

1956

ELEVATION

1842

REPORT

7-11

Comm. 7-5-56

8" @ 708 w/200

Drlg. 2290

Anh. 698'

9-5

Comm 7-5-56

Anh 698

H 3031

B1 3142

L 3154

C 3396

A 3420

TD 3425

8" @ 708/200

DST 3144-3215 1 hr rec 388'

HO &amp; GCM + 120' O &amp; GCM

+ 60' wtr BHP 1110/30"

DST 3218-30 1 hr rec 240'

GCMW + 1120' wtr BHP 950/30"

DST 3342-60 1 hr 650' gas rec

102' VHO &amp; GCM BHP 750

DST 3363-73 35" rec 25' md

BHP 40#

DST 3373-89 1 hr rec 100'

gas + 20' O &amp; GCM BHP 120

DST 3410-20 30" rec 2190'

gas + 1225' oil BHP 1050

OVER

1956

9-5

5 1/2" @ 3422 w/125  
CO 3425 FU 1330' wtr DD 3427  
GRNL SQD op hole PB?  
4/3413 FU 775' oil 9 1/2 hrs  
\$ 17.80 BO no wtr 3 hrs 400  
O.B. 12/3414-16 \$  
2 1/2 BOPH ~~xxxx~~ no wtr  
400' OB T & R  
P 25 BOPD no wtr Grav 32

COMPLETED

R. G.

County Barton Elev. 134  
 Sec. 26 Twp. 19 Rge. 13W  
 Company J. T. Ardelin & Sons, Inc.  
 Farm Name Nicholson No. 1

| TOPS   | DEPTH | LOG | DATUM | Loc. in Sec. |
|--------|-------|-----|-------|--------------|
| Anb.   | 628   |     |       |              |
| Tr.    |       |     |       |              |
| H.     | 3031  |     |       |              |
| Tr.    |       |     |       |              |
| Dg.    |       |     |       |              |
| BL.    | 3142  |     |       |              |
| L.     | 3154  |     |       |              |
| K.C.   |       |     |       | Geol.        |
| B.K.C. |       |     |       | Contr.       |
| Ce.    |       |     |       |              |
| C.     | 3396  |     |       | Harms-Burt   |
| M.     |       |     |       |              |
| M.     |       |     |       | Pool         |
| K.     |       |     |       |              |
| Mz.    |       |     |       | Red Brick    |
| Mo.    |       |     |       |              |
| V.     |       |     |       |              |
| S.     |       |     |       |              |
| S.     |       |     |       |              |
| A.     | 3420  |     |       |              |
| R.     |       |     |       |              |
| PE.    |       |     |       |              |
| G.     |       |     |       |              |
| T.D.   | 3425  |     |       |              |

COMPLETE

SEP 5 '56

Date Comm. 7-5-56

711 778/210 29 JUL 18 '56

DST 3144-3215 1hr rec 388'  
 HO & GCM + 120' O & GCM + 60'  
 wth BHP 1110/30" DST 3218-30  
 1hr rec 240' GCMW + 1120'  
 wth BHP 950/30" DST 3342  
 -60 1hr 650' gas rec 102'  
 VHO & GCM BHP 750 DST 3363  
 -73 35" rec 25' Md BHP 40#

DST 3373-89 1 hr. rec 100'

gas + 20' 05' GCM BHP 120

DST 3410-20 30" rec 2190'

gas + 1225' oil BHP 1050

5 1/2" @ 3422/125 JUL 25 '56 CO

3425 FU 1300' wtr DD 3427

GRNL SQd op. Hole. PB?

4/3413 FU 775' oil 9 1/2 hrs

\$ 17.80 BO no/w 3 hrs. 400

O.B. AUG 1 '56 12/3414-16 \$

2 1/2 Boph 7 hrs. no/wtr

400' O.B. T &amp; R AUG 8 '56

AUG 15 '56

AUG 22 '56

AUG 29 '56

SEP 5 '56

P. 25 Bopd no/wtr.

graw 32°

26-17-120

SW NE NG